


BROCKMAN AVE  
WATER & SEWER IN ST. RW

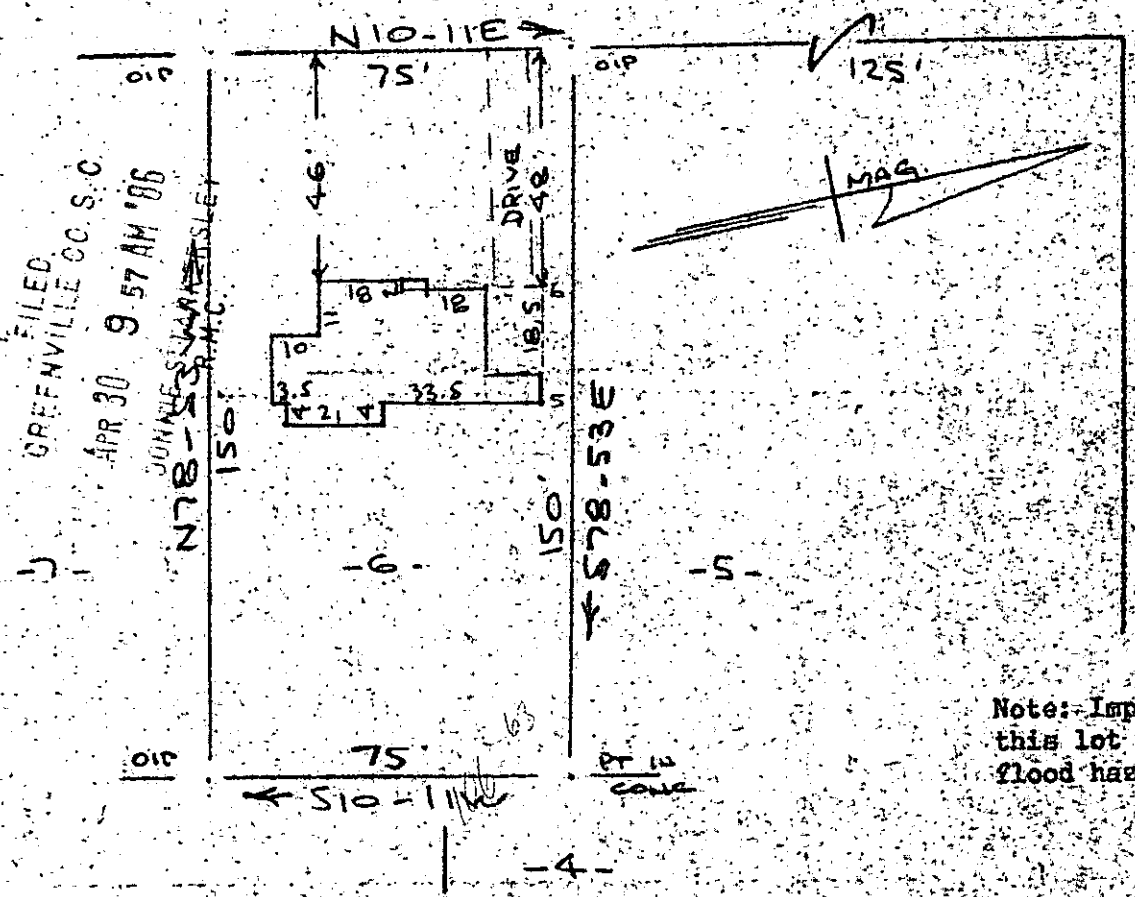

FILED  
GREENVILLE CO. S.C.  
APR 30 9 57 AM '86  
R.M.C.

Note: Improvements on this lot are not in a flood hazard area.

PROPERTY OF  
RICHARD D. REIS & BETTY G. REIS  
NEAR GREENVILLE, S.C.  
SCALE: 1" = 40' 24 APR 1986

This is to certify that on the 24th day of April, 1986, I surveyed the property shown on this plat, being known as lot 6 on plat of PROPERTY OF O. C. FREEMAN and recorded in the RMC Office Greenville County, S. C., in Plat Book "X" at Page 78; and that the property lines, walls and buildings are as shown hereon, and that the walls and buildings located on said lot do not encroach or project on adjacent street or property, and that no adjacent walls or buildings encroach or project on said premises, and no power lines cross this property except as shown hereon.

35736 ✓  
R. B. Bull  
R. B. Bull  
Recordable Plat

12-Q-57  
APR 30 1986

CAROLINA SURVEYING CO.  
112 Hanly St.  
Greenville, S. C.