

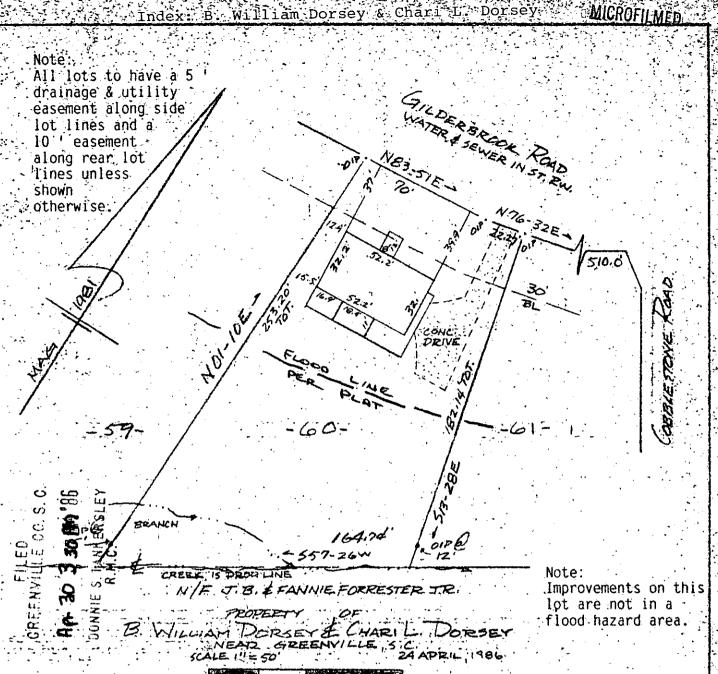

This is to certify that on the 24th day of April, 1986, I surveyed the property shown on this plat, being known as lot 60 on plat of BROOKFIELD WEST SECTION II and recorded in the RMC Office Greenville County, S. C., in Plat Book " 7 - X " at Page 88; and that the property lines, walls and buildings are as shown hereon, and that the walls and buildings located on said lot do not encroach or project on adjacent street or property, and that no adjacent walls or buildings encroach or project on said premises no power lines cross this property and no visible encroachments except as APR 30 1986 shown hereon.

12 - 0 - 75 35814 R. B. Bruce, RLSWE 1952

SURVEYING CAROLINA -112 Manly Greenville,