MICROFILMED

FILED
GREENVILLE CO. S.C.
MAY 8 10 59 AM '86
DONNIE S. TANKERSLEY
R.M.C.

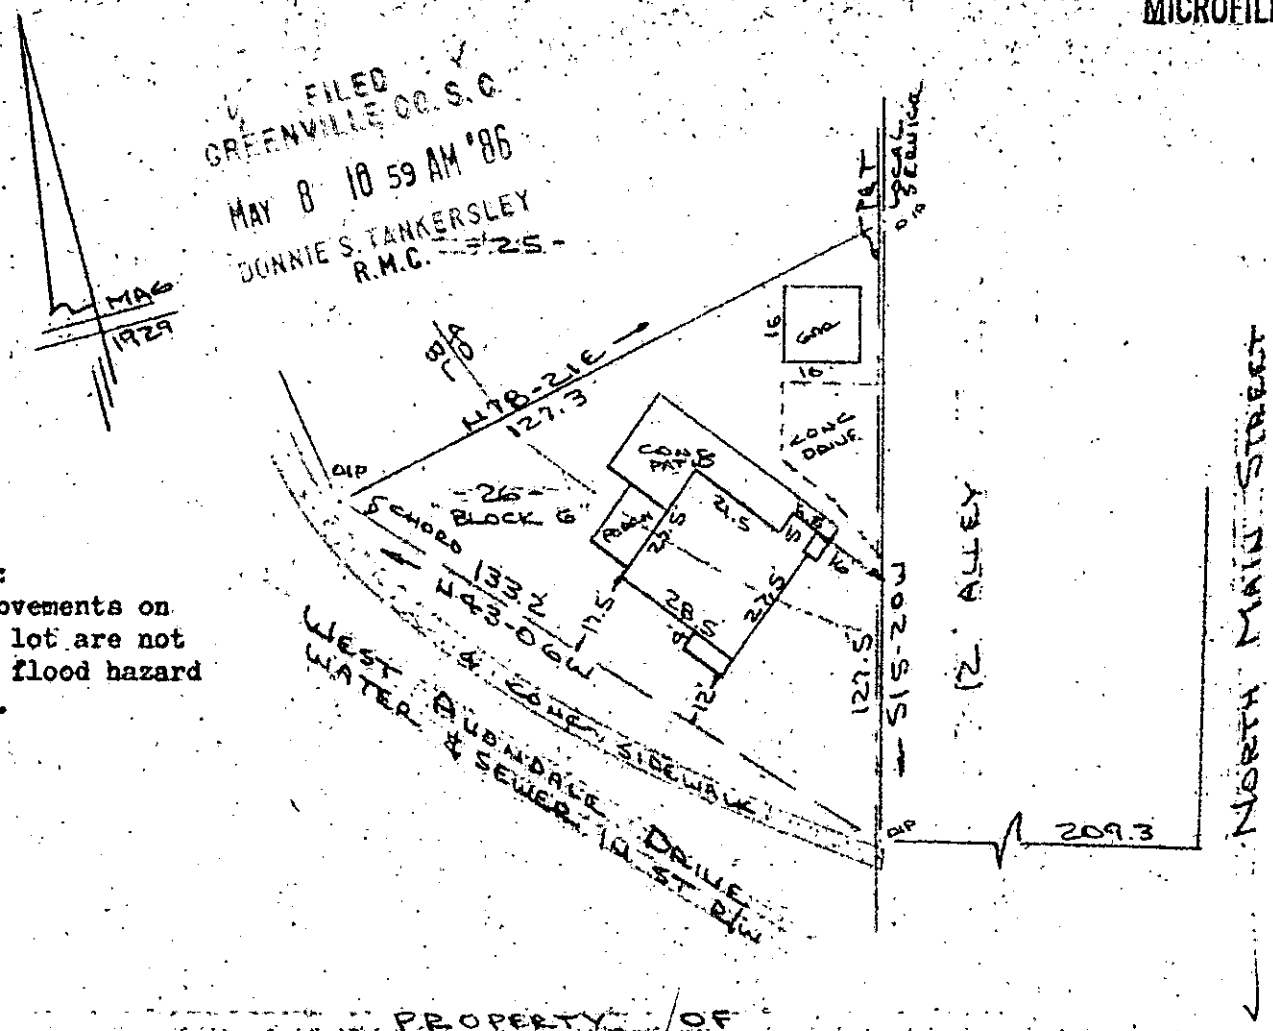

Note:
Improvements on this lot are not in a flood hazard area.

PROPERTY OF
DOUGLAS E. PHILLIPS & MARTHA P. MURDOCH
GREENVILLE COUNTY, GREENVILLE, S.C.
SCALE: 1"=40' 28 APR 1986

This is to certify that on the 28th day of April, 1986, I surveyed the property shown on this plat, being known as lot 26 Block " G " on plat of NORTHGATE " and recorded in the RMC Office Greenville County, S. C., in Plat Book " G " at Pages 135 & 136; and that the property lines, walls and buildings are as shown hereon, and that the property lines, walls and buildings located on said lot do not encroach or project on adjacent street or property, and that no adjacent walls or buildings encroach or project on said premises, and no power lines cross this property except as shown hereon. Also being known as PROPERTY OF DOUGLAS E. PHILLIPS & MARTHA P. MURDOCH and recorded in the RMC Office Greenville County, S. C., in Plat Book 11-A at Page 67

36913

12-S-24

MAY 8 1986

R. B. Bruce, RLS# 1952

Recordable Plat

CAROLINA SURVEYING CO.
112 Manly St.
Greenville, S. C.