


FILED
GREENVILLE CO. S.C.
MAY 20 1 51 PM '86
JIM S. TANKERSLEY
R.M.C.

ALICE STREET

38406 MAY 20 1986

12-5-91

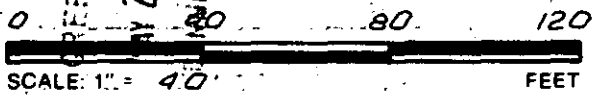

This property falls into the area covered by FIRM MAP #450089-C145A EFFECTIVE DATE: 12-2-80

THIS IS TO CERTIFY THAT THE PROPERTY SHOWN ON THIS PLAT WAS SURVEYED UNDER MY DIRECT SUPERVISION. PROPERTY LINES AND IMPROVEMENTS SHOWN ARE LOCATED CORRECTLY AND THAT NO VISIBLE ENCROACHMENTS EXIST UNLESS OTHERWISE SHOWN. THIS PROPERTY IS NOT LOCATED IN A DESIGNATED FLOOD HAZARD AREA.

REGISTERED LAND SURVEYOR
No. 4781
JAMES RALPH FREELAND

R/S: JAMES R. FREELAND
NO: 4781

STATE OF SOUTH CAROLINA
GREENVILLE COUNTY

WOODVILLE HEIGHTS
SEC. F, PART LOT 1 & LOT 2
PROPERTY OF
GARY C. McDOWELL
LISA M. McDOWELL

FREELAND-CLINKSCALES & ASSOCIATES, INC.
Engineers • Land Surveyors
323 WEST STONE AVENUE
GREENVILLE, S.C.
(803) 271-4924

PLAT BOOK	5E-40
DEED BOOK	391-619
TAX MAP	127-2-10
PARTY CHIEF	J.C.C.
DRAWN	I.R.
DATE	MAY-14-86
DWG. NO.	15222