

FILED  
 GREENVILLE CO. S.C.  
 MAY 23 3 39 PM '86  
 JONNIE S. TANKERSLEY  
 R.M.C.

MAY 23 1986  
 12-T-14  
 JOE WILSON  
 38956

- NOTES:
1. THIS DWELLING IS NOT LOCATED IN A FLOOD DISASTER AREA.
  2. PROPERTY IS SUBJECT TO ANY AND ALL RIGHTS-OF-WAY AND EASEMENTS OF RECORD.

THIS IS TO CERTIFY THAT ON THE DATE SHOWN HEREON, I DID SURVEY THE ABOVE PROPERTY, THE SAME BEING KNOWN AND DESIGNATED AS MAJOR PORTION OF LOT 31-SEC #2 BELLE TERRE ACRES AS SHOWN BY A PLAT RECORDED IN THE CLERK OF COURTS OFFICE FOR GREENVILLE COUNTY IN PLAT BOOK 4-F AT PAGE 8 & 9. I FURTHER CERTIFY THAT THE PROPERTY LINES, STREETS, AND BUILDINGS ARE AS SHOWN ABOVE AND THAT THERE ARE NO ENCROACHMENTS EXCEPT AS SHOWN.

MAY 20, 1986  
 DATE


*Robert R. Spearman*  
 ROBERT R. SPEARMAN REG. L. S. NO. 3615

TITLE  
 SURVEY FOR  
 LARRY WAYNE ROGERS  
 &  
 MARTHA ANN BENNETT

LEGEND

- IRON PIN (OLD)
- IRON PIN (NEW)
- △ NAIL & CAP
- AS NOTED

GRAPHIC SCALE  
 30 0 60

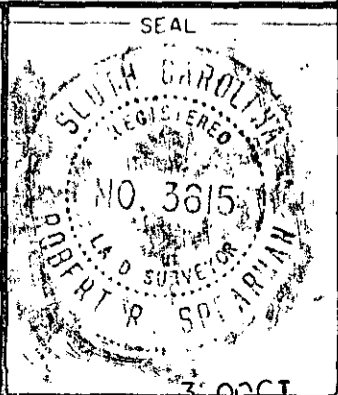

STATE SOUTH CAROLINA COUNTY GREENVILLE  
 SCALE 1"=60 DATE 5/20/86 REF. NO. 11481

ROBERT R. SPEARMAN  
 Registered Surveyor 3615  
 Post Office Box 6  
 Easley, South Carolina 29640  
 PH. 803-859-2309