


SECTION 4

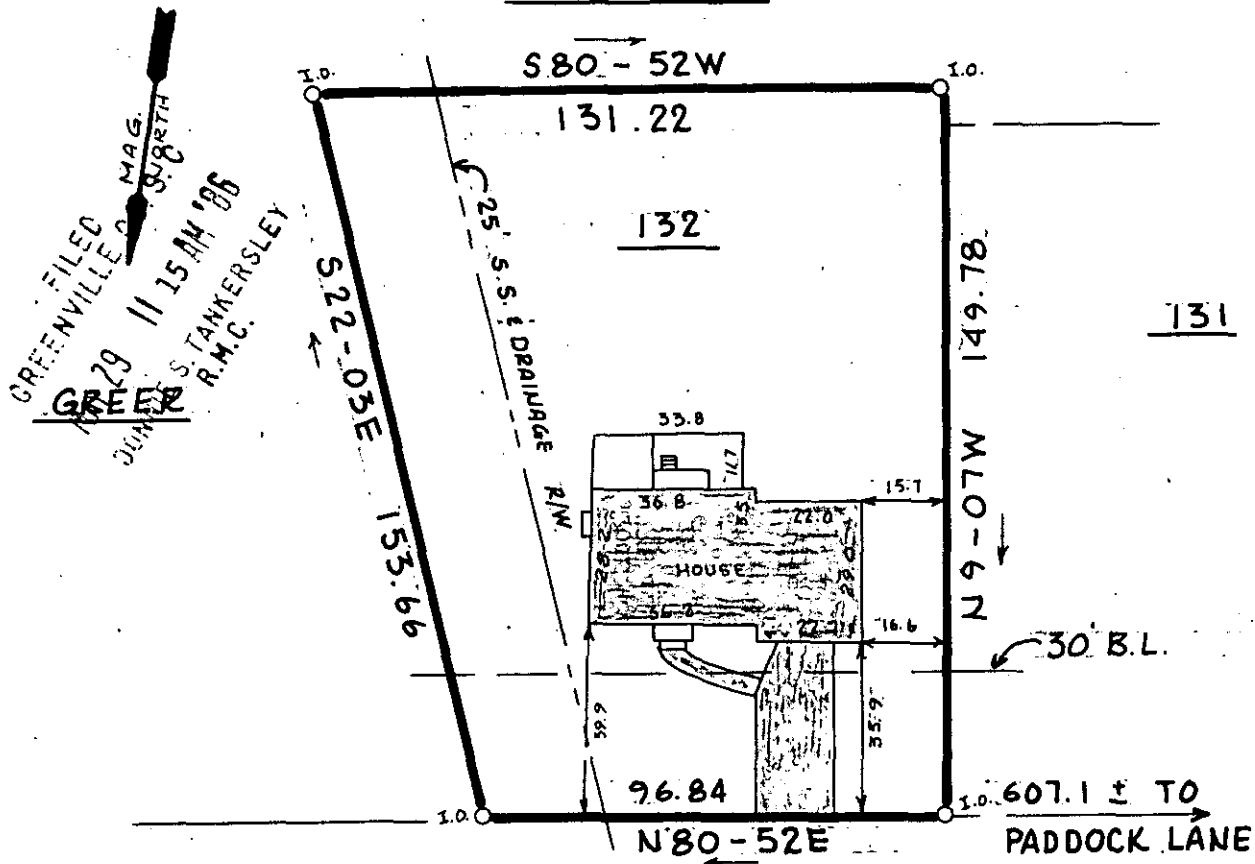


NOTE:  
DRAINAGE EASEMENT  
ALONG ALL REAR AND  
SIDE LOT LINES.

ROSEBUD LANE


39640

12-7-48

MAY 29 1986

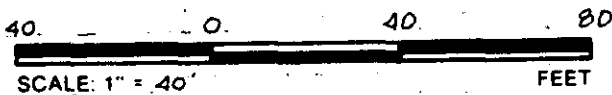

THIS IS TO CERTIFY THAT THE PROPERTY SHOWN ON THIS PLAT WAS SURVEYED UNDER MY DIRECT SUPERVISION. PROPERTY LINES AND IMPROVEMENTS SHOWN ARE LOCATED CORRECTLY AND THAT NO VISIBLE ENCROACHMENTS EXIST UNLESS OTHERWISE SHOWN. THIS PROPERTY IS NOT LOCATED IN A DESIGNATED FLOOD HAZARD AREA.

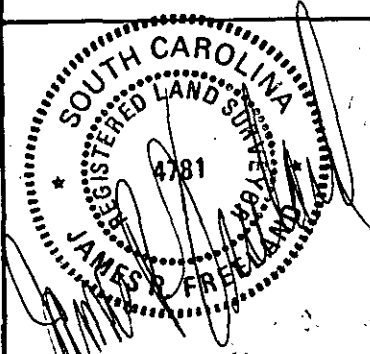

**STATE OF SOUTH CAROLINA  
GREENVILLE COUNTY**

**FREELAND-CLINKSCALES  
& ASSOCIATES, INC.**

Engineers • Land Surveyors  
323 WEST STONE AVENUE  
GREENVILLE, S.C.  
(803) 271-4924

DEVENGER PLACE

LOT 132, SEC 5

PROPERTY OF

THOMAS P. McNAMEE

MARCIA A. McNAMEE

PLAT BOOK 64-73

DEED BOOK 1113-13

TAX MAP

PARTY CHIEF M. E.

DRAWN D. L. B.

DATE 5-22-86

RLS JAMES R. FREELAND  
NO. 4781

GRV -- 13 MY 29 86

730WG-NO. 15298.0001