


Note: Improvements on this lot are not in a flood hazard area.

GREENVILLE CO. S.C.
MAY 29 11 38 AM '86
DUNNIE S. WALKERSLEY
R.M.C.

DRURY LANE
WATER & SEWER IN ST R/W
PROPERTY OF
BYRON KEITH WILLIAMS
MAULDIN S.C.
SCALE 1"=40' 15 MAY 1986

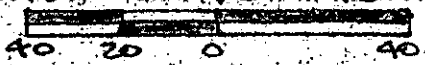

MAY 29 1986

This is to certify that on the 15th day of May, 1986, I surveyed the property shown on this plat, being known as lot 133 on plat of EASTDALE DEVELOPMENT and recorded in the RMC Office Greenville County, S. C., in Plat Book "YY" at Pages 118 & 119; and that the property lines, walls and buildings are as shown hereon, and that the walls and buildings located on said lot do not encroach or project on adjacent street or property, and that no adjacent walls or buildings encroach or project on said premises, no power lines cross this property and no visible encroachments except as shown hereon.

12-T-50

39643 R. B. Bruce

R. B. Bruce, RLS # 1952

CAROLINA SURVEYING CO. Recordable Plat

112 Manly St.
Greenville, S. C.