

FILED
 GREENVILLE CO. S.C.
 MAY 30 3 18 PM '86
 JOHNNIE STANKERSLEY
 R.M.C.

PROPERTY OF
DANIEL G. LANGLEY & ANGELA P. LANGLEY
 CITY OF GREENVILLE, S.C.
 SCALE 1"=40' 16 MAY 1986



This is to certify that, on the 16th day of May, 1986, I surveyed the property shown on this plat, being known as lot 30 on plat of PLAT NO. 2 SUNSET HILLS and recorded in the RMC Office Greenville County, S. C., in Plat Book "P." at Page 19; and that the property lines, walls and buildings are as shown hereon, and that the walls and buildings located on said lot do not encroach or project on adjacent street or property, and that no adjacent street or property, and that no adjacent walls or buildings encroach or project on said premises, and that no power lines cross this property and no visible encroachments except as shown hereon.


12-T-72

39830

R. B. Bruce
 R. B. Bruce, RLS # 1952

CAROLINA
 112 Manly St.
 Greenville, S. C.

CO: Recordable Plat

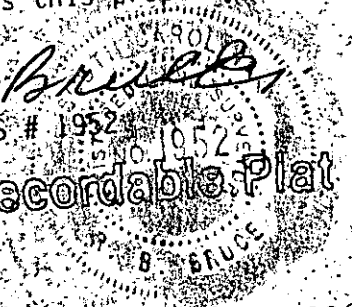

3-MY30.86 1065

3.00CI

221-1-76