MICROFILMED

FILED
GREENVILLE CO. S.C.
MAY 30 4 42 PM '86
DONNIE S. TANKERSLEY
R.M.C.

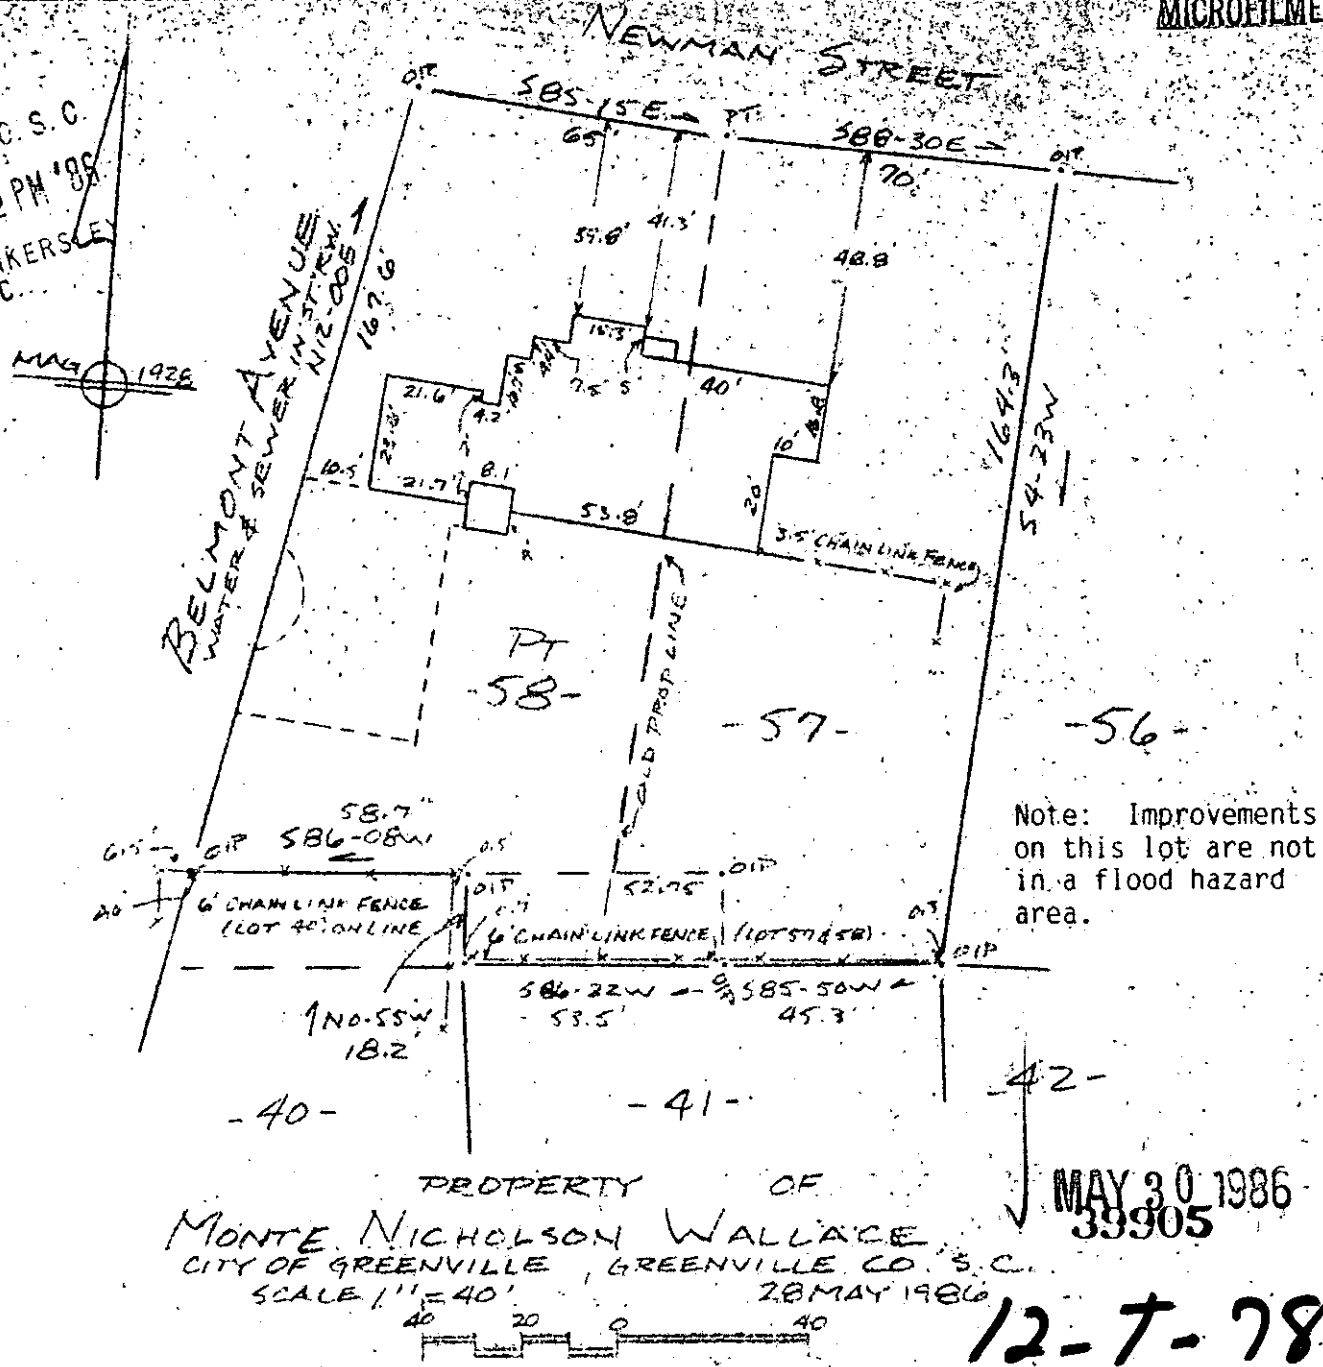

Note: Improvements on this lot are not in a flood hazard area.

MAY 30 1986
39905

12-7-78

This is to certify that on the 28th day of May, 1986, I surveyed the property shown on this plat, being known as lot 57 and part of lot 58 on plat of McDANIEL HEIGHTS and recorded in the RMC Office Greenville County, S. C., in Plat Book " P " at Page 87 and also known as PROPERTY OF MONTE NICHOLSON WALLACE and recorded in the RMC Office Greenville County, S. C., in Plat Book " " at Page ; and that the property lines, walls and buildings are as shown hereon, and that the walls and buildings located on said lot do not encroach or project on adjacent street or property, and that no adjacent walls or buildings encroach or project on said premises, no power lines cross this property and no visible encroachments except as shown hereon.

R. B. Bruce

R. B. Bruce, RLS 1952

CAROLINA SURVEYING CO.
112 Manly St.
Greenville, S. C.

Recordable Plat

306/21 67.5-4-PT 3 MY 30 86 1145 3.00CI