


CHICK
HAMPTON
PARTNERS

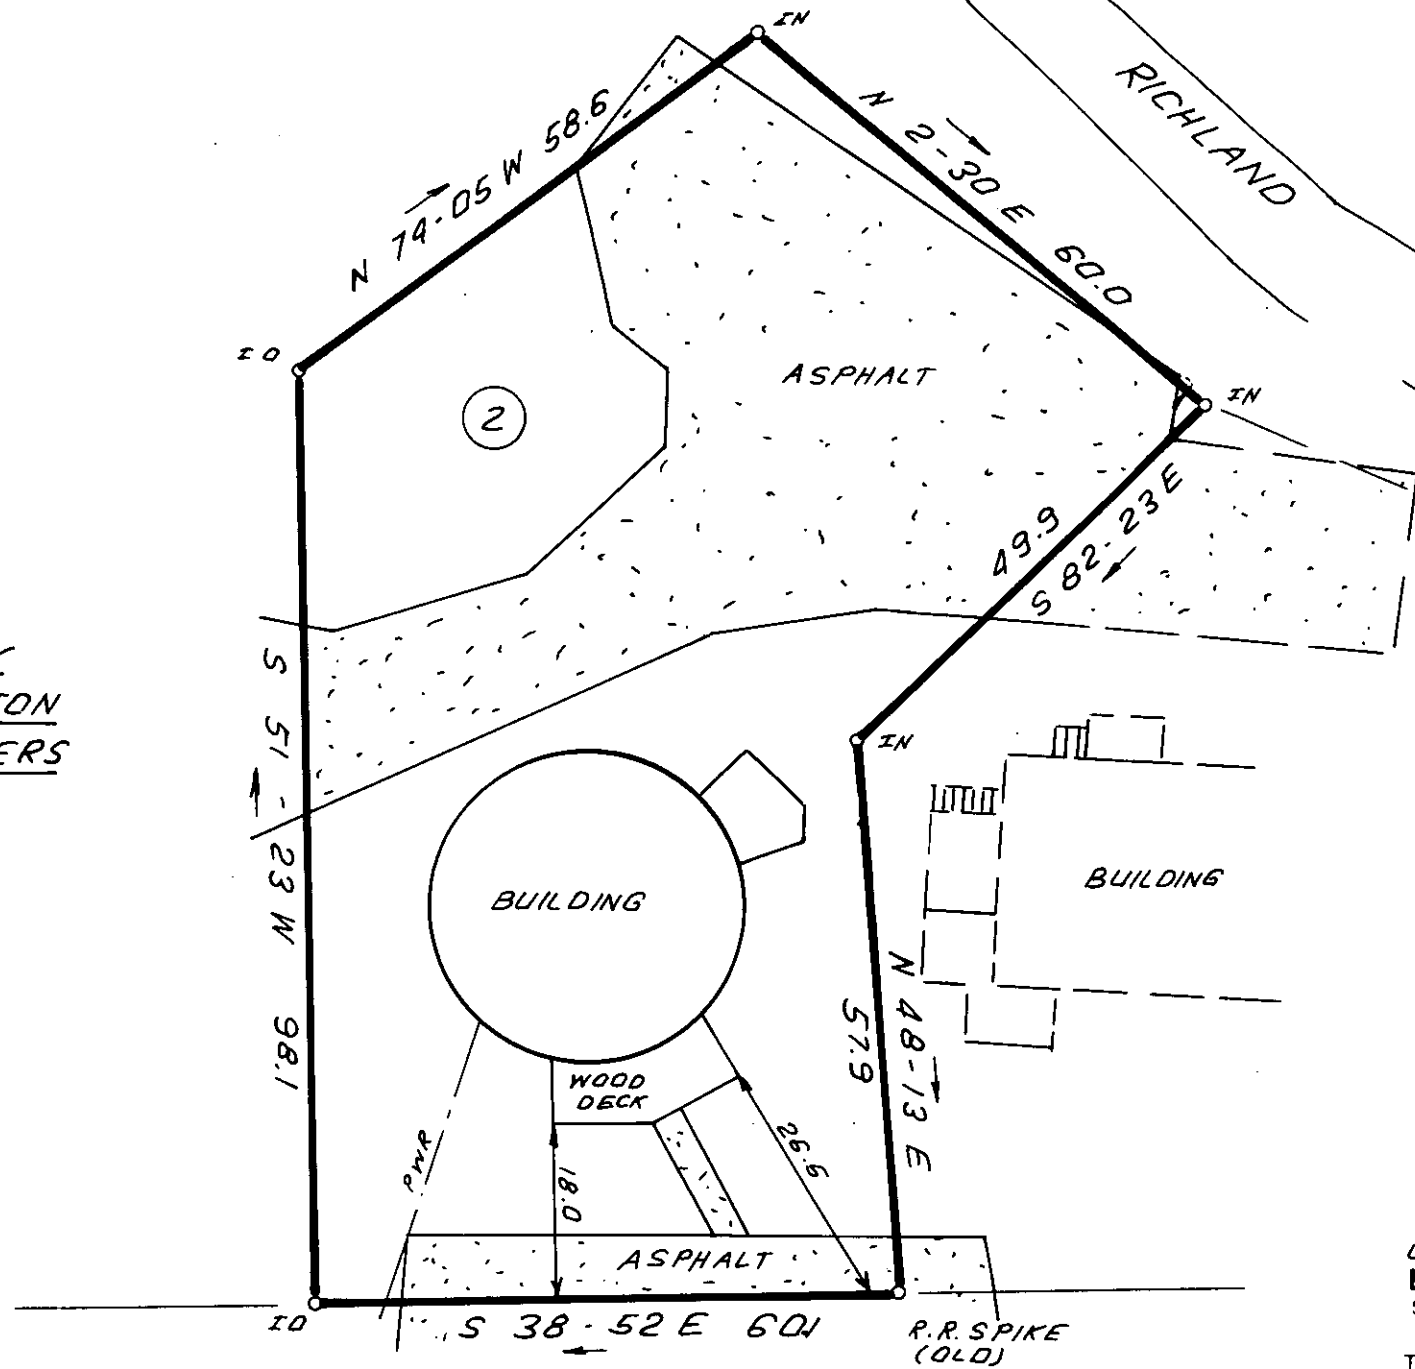


CHICK SPRINGS ROAD

✓ 122-74

271

RIDGECREST
DRIVE

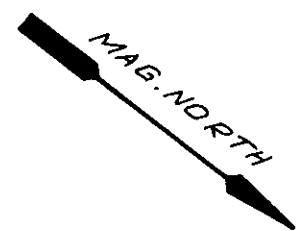

THIS IS TO CERTIFY THAT THE PROPERTY SHOWN ON THIS PLAT WAS SURVEYED UNDER MY DIRECT SUPERVISION. PROPERTY LINES AND IMPROVEMENTS SHOWN ARE LOCATED CORRECTLY AND THAT NO VISIBLE ENCROACHMENTS EXIST UNLESS OTHERWISE SHOWN. THIS HOUSE IS NOT LOCATED IN A DESIGNATED FLOOD HAZARD AREA.

GREENVILLE CO. S.C.
 JUL 1 4 43 PM '86
 DONNIE S. TANKERSLEY
 R.M.C.

JUL 1 1986

SOUTH CAROLINA
 REGISTERED LAND SURVEYOR
 4781
 JAMES R. FREELAND
 RLS: JAMES R. FREELAND
 NO. 4781

STATE OF SOUTH CAROLINA
 GREENVILLE COUNTY

PROPERTY OF
 JOSEPH P. DONOHUE ✓
 SANDRA S. MORGAN ✓

FREELAND & ASSOCIATES
 Engineers • Land Surveyors
 318 WEST STONE AVENUE.
 GREENVILLE, S.C.
 (803) 271-4924

PLAT BOOK
DEED BOOK
TAX MAP 189.1-1-9
PARTY CHIEF G.P.
DRAWN I.R.
DATE JUNE - 12 - 85
DWG. NO. 189.1-1-9-2

500