

Note: Improvements on this lot are not in a flood hazard area.

JUN 3 1986


ROCKCREST DRIVE  
WATER IN ST. RW

12-V-5

PROPERTY OF  
RAYMOND T. WASHELESKI & GERALDINE D. WASHELESKI  
GREENVILLE COUNTY, S.C.

SCALE 1"=40' 26 MAY 1986

40357

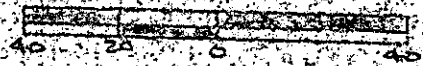

This is to certify that on the 26th day of May, 1986, I surveyed the property shown on this plat, being known as lot 42 on plat of TERRACE GARDENS and recorded in the REC Office Greenville County, S. C., in Plat Book "QQ" at Page 85; and that the property lines, walls and buildings are as shown hereon, and that the walls and buildings located on said lot do not encroach or project on adjacent street or property, and that no adjacent walls or buildings encroach or project on said premises, and no power lines cross this property except as shown hereon.

*R. B. Brute*  
R. B. Brute  
R. B. Brute, RLS #1952

CAROLINA SURVEYING CO.  
112 Nanly St.  
Greenville, S. C.

Recordable Plat

JUN 3 1986 1414

3.0001

251/38

532.6-1-24