

FILED  
GREENVILLE CO. S. C.  
JUN 3 10 57 AM '86  
DONNIE S. TANKERSLEY  
R.M.C.



CREEK IS  
PROPERTY  
LINE


ADLER  
DRIVE

TEBBLEWOOD DRIVE

AGEWOOD DR

NOTES:

1. 5' DRAINAGE & UTILITY EASEMENT EACH SIDE ALL SIDE & REAR LOT LINES \* UNLESS SHOWN OTHERWISE.
2. 20' DRAINAGE EASEMENT ALONG CREEK AS SHOWN.

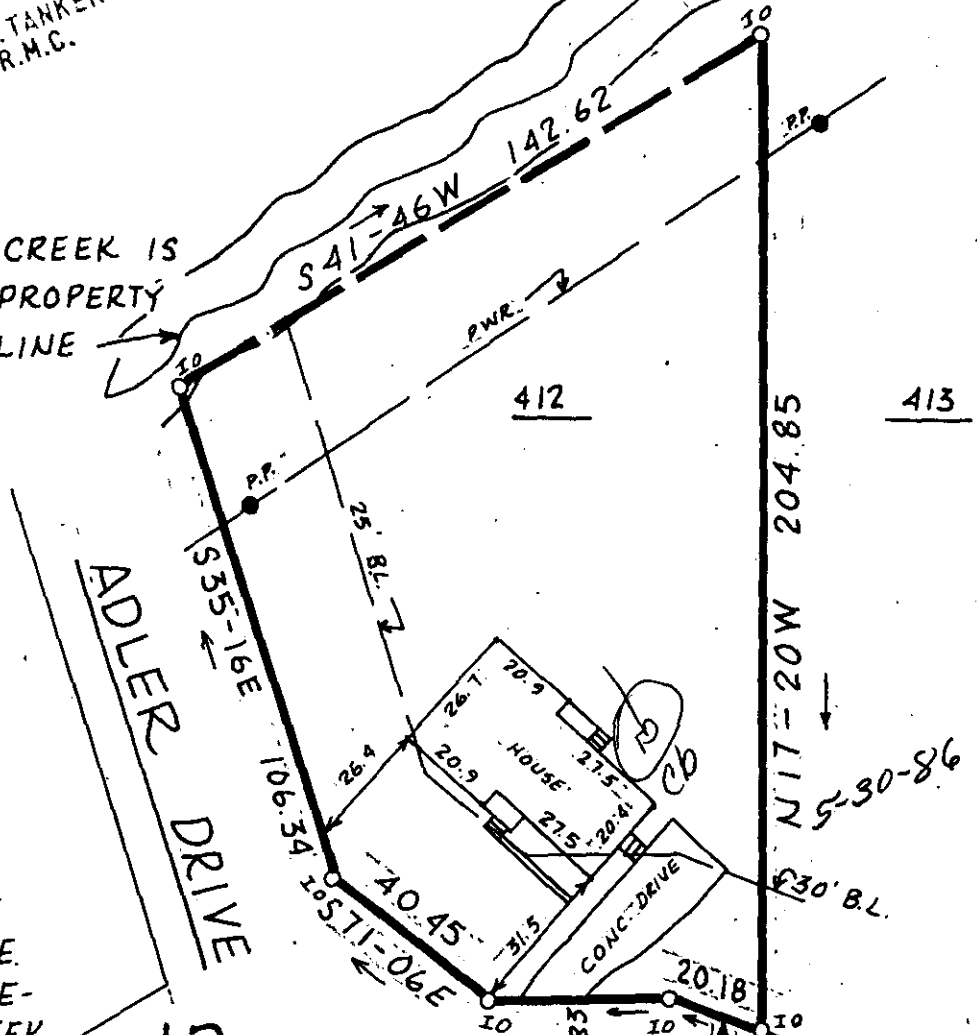


12-V-6

JUN 3 1986

40359

THIS IS TO CERTIFY THAT THE PROPERTY SHOWN ON THIS PLAT WAS SURVEYED UNDER MY DIRECT SUPERVISION. PROPERTY LINES AND IMPROVEMENTS SHOWN ARE LOCATED CORRECTLY AND THAT NO VISIBLE ENCROACHMENTS EXIST UNLESS OTHERWISE SHOWN. THIS HOUSE IS NOT LOCATED IN A DESIGNATED FLOOD HAZARD AREA.

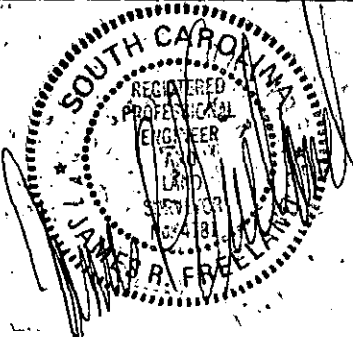

RLS: JAMES R. FREELAND  
NO: 4781

STATE OF SOUTH CAROLINA  
GREENVILLE COUNTY

WESTWOOD  
SEC. 5, LOT 412  
PROPERTY OF  
RICKY D. BARBERY  
CATHERINE R. BARBERY

FREELAND-CLINKSCALES & ASSOCIATES, INC. Engineers • Land Surveyors 323 WEST STONE AVENUE GREENVILLE, S.C. (803) 271-4924	
PLAT BOOK	4 X P.62
DEED BOOK	
TAX MAP	574-10-1-21
PARTY CHIEF	P. A. J.
DRAWN	D. L. B.
DATE	5-29-86
DWG. NO.	15352