


FILED  
GREENVILLE CO. S.C.

JUN 5 4 42 PM '86

DONNIE S. TANKERSLEY  
R.M.C.

Note:  
Improvements on this  
lot are not in a  
flood hazard area.

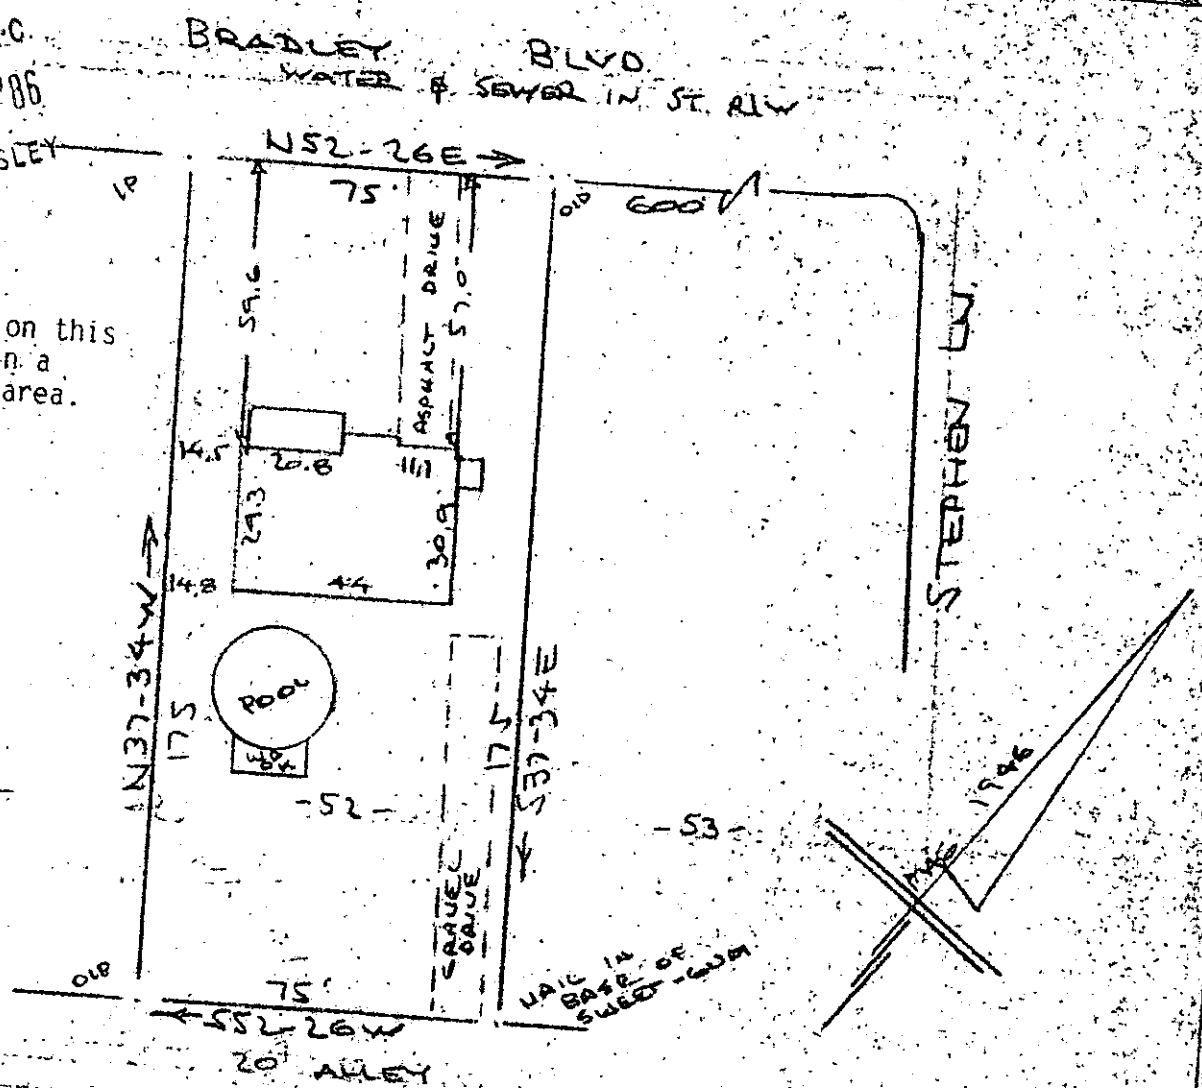

PROPERTY OF  
EUGENE W. GUYDAM, III  
CITY OF GREENVILLE, S.C.  
SCALE: 1" = 40' 2 JUNE 1986

This is to certify that on the 2nd day of June, 1986, I surveyed the property shown on this plat, being known as lot 52 on plat of UNIVERSITY PARK and recorded in the RMC Office Greenville County, S.C., in Plat Book "P" at Page 127; and that the property lines, walls and buildings are as shown hereon, and that the walls and buildings located on said lot do not encroach or project on adjacent street or property, and that no adjacent walls or buildings encroach or project said premises, and no power lines cross this property except as shown hereon.

40771 R. B. Bruce, RLS #19527

12-V-25

JUN 5 1986

CAROLINA SURVEYING  
112 Manly St.  
Greenville, S.C.



300 3  
31A01

UB (2094)

274.4-1-22

9803