


FILED
GREENVILLE CO. S. C.

370-13 10 40 AM '86
DONNIE S. TANKERSLEY
R.M.C.

14

13

12

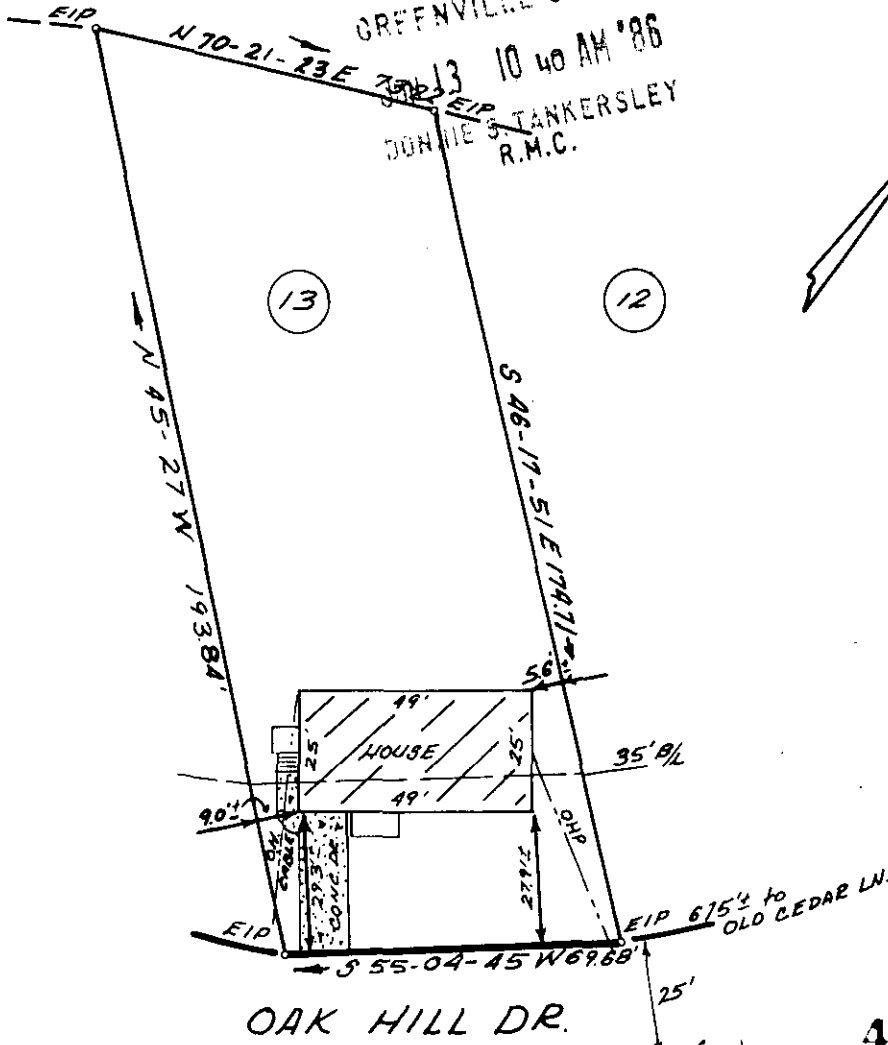

41859

PROPERTY OF
PAUL E. FLEMING

JUN 13 1986


OLETHIA L. GAINES 12-V-66

GREENVILLE, GREENVILLE COUNTY S.C.

JUNE 9, 1986 SCALE 1"=40'

This is to certify that on June 9, 1986, I surveyed the property shown on this plat, known as Lot No. 13 of Oak Hill, Sec. "A" and "B", as recorded in the RMC Office for Greenville County, in Plat Book MM, Page 81, and that the property lines, walls and buildings are as shown hereon, and that the building located on said lot does not project nor encroach on adjacent streets or property, and that no adjacent walls or buildings project nor encroach on said lot, and that no utility lines cross this lot except as may be shown hereon or for separate record. The degree of accuracy is 1/10,000.

NOTE: This property is not located within a flood hazard area.

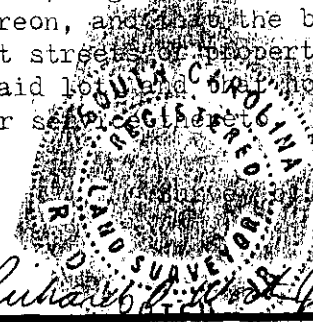

RECORDABLE PLAT

Richard D. Wooten, Jr.
Greenville, South Carolina

Richard D. Wooten, Jr.
S. C. R. L. S. No. 4678

SC10 -- 3 JUN 13 1986 1039

3.0001