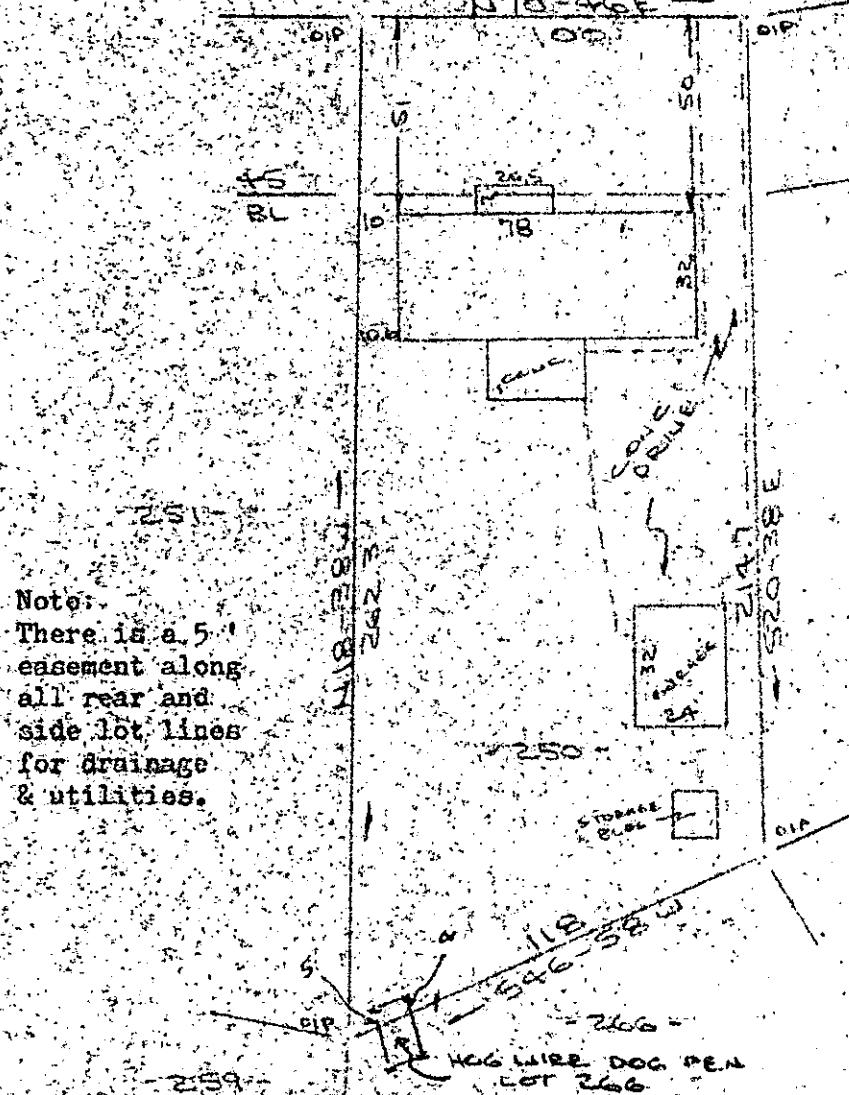


BUCKINGHAM ROAD  
LOT 250 & EASEMENT PLAT

Note:  
Improvements on this  
lot are not in a flood  
hazard area.

-249-

-247-

JUN 20 1986

JUN 20 1986  
12 06 PM '86  
JOHNSON & JANKERSLE  
R.M.C.

PROPERTY OF  
MARSHALL E. SARGENT & Gloria B.  
GREENVILLE, S.C.

SCALE 1" = 50 FEET JUNE 1986

This is to certify that on the 6th day of June, 1986, I surveyed the property shown on this plat, being known as lot 250 on plat of SECTION B MAP OF GOVER ESTATES and recorded in the RMC Office Greenville County, S. C., in Plat Book "X" at Page 36; and that the property lines, walls and buildings are as shown hereon, and that the walls and buildings located on said lot do not encroach or project on adjacent street or property, and that no adjacent walls or buildings encroach or project on said premises, and no power lines cross this property except as shown hereon.

42939

12-W-30

CAROLINA SURVEYING CO.  
112 Manly St.  
Greenville, S.

R. B. Bruce  
R. B. Bruce  
BY R. Bruce, RLS #1952  
Recordable Plat