


MICROFILMED

Note: Improvements on this lot are not in a flood hazard area.

GREENVILLE, S.C.
JUN 24 9 39 AM '86
JOHNIE S. FINKERSLEY
R.M.C.

PROPERTY OF
ASHLEY R. BENTON &
LINDA G. BENTON
NEAR GREENVILLE
GREENVILLE COUNTY, S.C.
SCALE 1" = 50' - 9 JUNE 1986

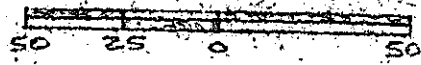

STARBUCKS SPRINGS ROAD

W/ FENCE ET AL

0.64 AC
SEPTIC TANK
ON LOT

210
548-424

W/ FENCE

GRAVEL DRIVE

210
548-424

210
548-424

510
double
line

ROAD

This is to certify that on the 9th day of June, 1986, I surveyed the property shown on this plat, being known as 0.64 ac. plat of ASHLEY R. BENTON & LINDA G. BENTON and recorded in the R.M.C. Office Greenville County, S. C., in Plat Book at Page ; and that the property lines, walls and buildings are as shown hereon, and that the walls and buildings located on said lot do not encroach or project on adjacent street or property, and that no adjacent walls or buildings encroach or project on said premises, and no power lines cross this property except as shown hereon.

12-W-39 43251

R. B. Bruce
R. B. Bruce

JUN 24 1986

CAROLINA SURVEYING CO.
112 Manly St.
Greenville, S. C.

R. B. Bruce, RLS # 1952

Recordable Plat