


FILED
GREENVILLE CO. S. C.

JUN 24 9 59 AM '86

DONNIE S. TANKERSLEY
R.M.C.

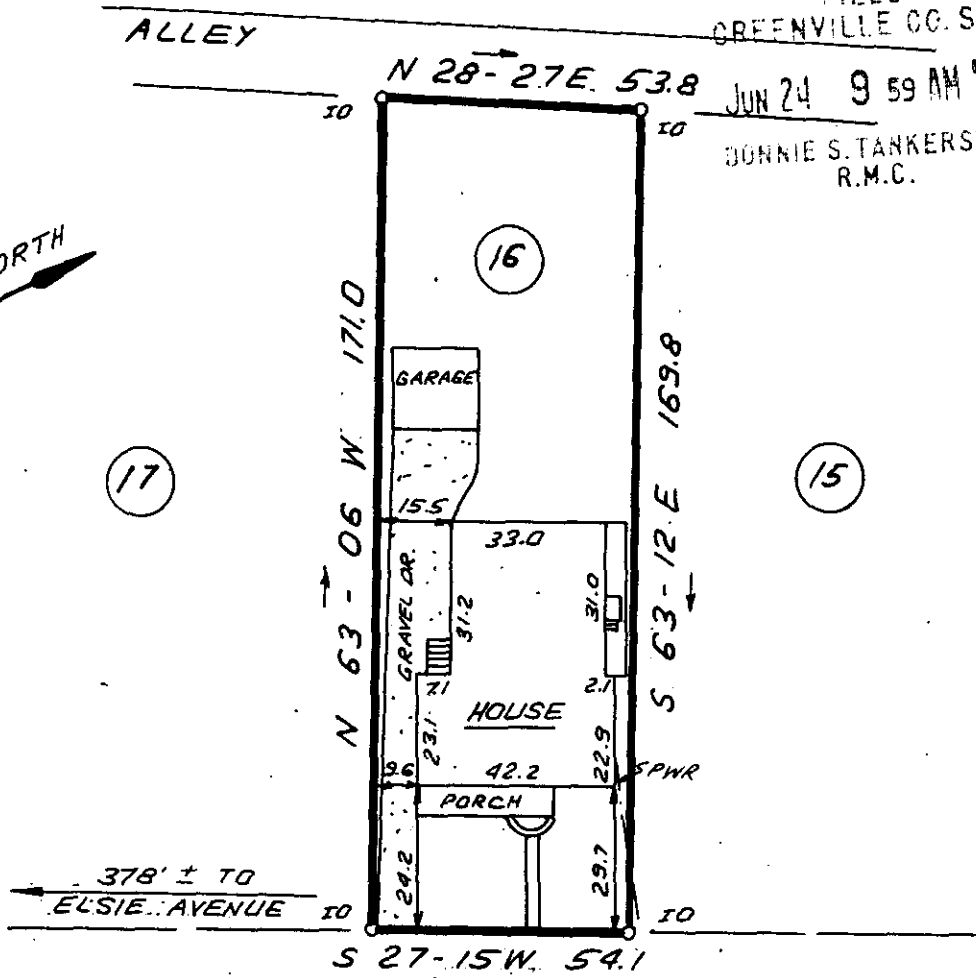

CONESTEE AVENUE


✓ 43250



12-W-40

JUN 24 1986

THIS IS TO CERTIFY THAT THE PROPERTY SHOWN ON THIS PLAT WAS SURVEYED UNDER MY DIRECT SUPERVISION. PROPERTY LINES AND IMPROVEMENTS SHOWN ARE LOCATED CORRECTLY AND THAT NO VISIBLE ENCROACHMENTS EXIST UNLESS OTHERWISE SHOWN. THIS PROPERTY IS NOT LOCATED IN A DESIGNATED FLOOD HAZARD AREA.

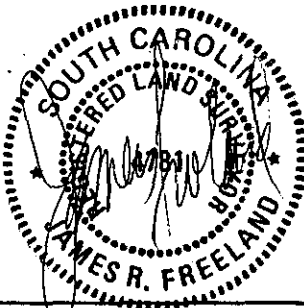

RLS JAMES R. FREELAND
NO. 4781

STATE OF SOUTH CAROLINA
GREENVILLE COUNTY

CHEROKEE PARK
LOT 16
PROPERTY OF
GREGORY R. HAMMERSLEY
KATHERINE A. HAMMERSLEY

FREELAND-CLINKSCALES
& ASSOCIATES, INC.

Engineers • Land Surveyors
323 WEST STONE AVENUE
GREENVILLE, S.C.
(803) 271-4324

| | |
|-------------|------------|
| PLAT BOOK | C.-96 |
| DEED BOOK | 1103-829 |
| TAX MAP | 218-3-18 |
| PARTY CHIEF | J.P.S |
| DRAWN | I.R. |
| DATE | JUNE 23-86 |
| DWG. NO. | 15581 |