


This is to certify that on JUNE 10,1986. I surveyed the property shown on this plat, known as Pt. Lot 141 on plat of Coach Hills, recorded in the RMC Office of Greenville County in Plat Book 4X on page 94, and that the property lines, walls and buildings are as shown hereon; that the building located on said lot does not encroach or project on adjacent streets or property, and that no adjacent walls or buildings encroach or project on said premises, and that no utility lines cross this property except as shown hereon. This property is not located in a designated flood hazard area.

5' drainage and utility easement each side of all side and rearlot lines.

12-W-54

43483

James R. Freeland RLS & PE 4781

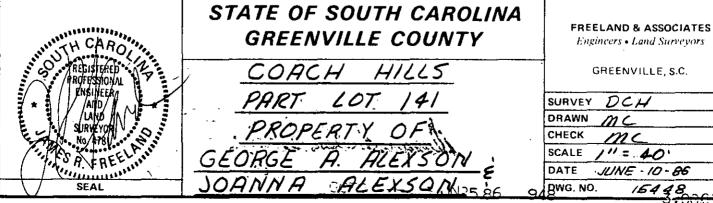

(5545)