


FILED  
GREENVILLE CO. S.C.

JUN 30 4 25 PM '86

JOHNNIE S. TANKERSLEY  
R.M.C.

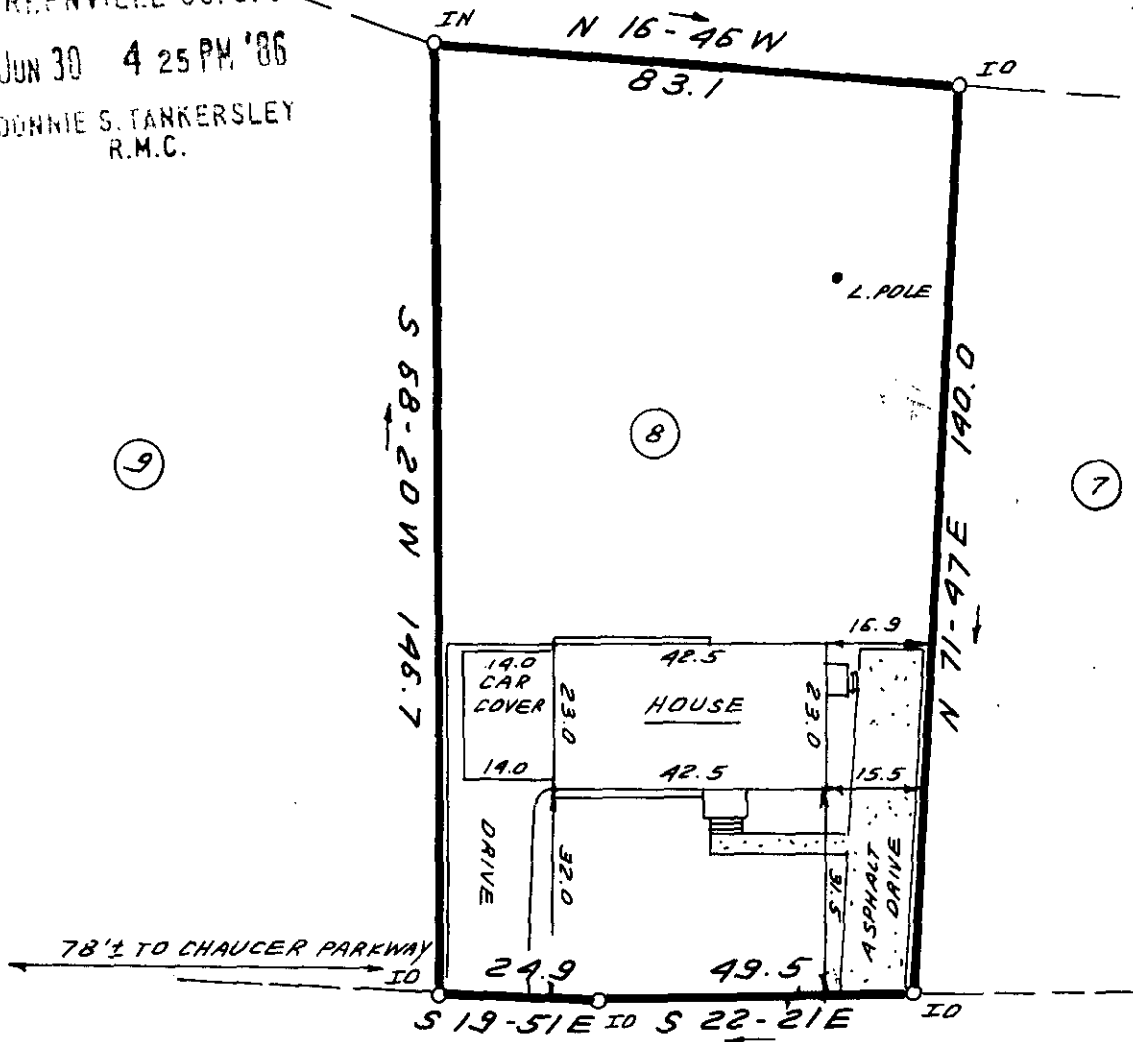

JUN 30 1986

SHEFFIELD DRIVE



41091  
12-W-99

THIS IS TO CERTIFY THAT THE PROPERTY SHOWN ON THIS PLAT WAS SURVEYED UNDER MY DIRECT SUPERVISION. PROPERTY LINES AND IMPROVEMENTS SHOWN ARE LOCATED CORRECTLY AND THAT NO VISIBLE ENCROACHMENTS EXIST UNLESS OTHERWISE SHOWN. THIS PROPERTY IS NOT LOCATED IN A DESIGNATED FLOOD HAZARD AREA



**STATE OF SOUTH CAROLINA  
GREENVILLE COUNTY**

CANTERBURY  
SEC. 1; LOT 8  
PROPERTY OF  
GERALD A. LANE  
JENNIFER B. LANE

**FREELAND-CLINKSCALES  
& ASSOCIATES, INC.**

Engineers • Land Surveyors  
323 WEST STONE AVENUE  
GREENVILLE, S.C.  
(803) 271-4924

PLAT BOOK	50-52
DEED BOOK	1140-332
TAX MAP	602.03-1-8
PARTY CHIEF	J.E.
DRAWN	BR
DATE	6-27-86
DWG. NO.	15636

PLS: JAMES R. FREELAND  
NO: 4781