


Note: Improvements on this lot are not in a flood hazard area.

Note: Drainage & utilities easement 5' each side of all side & rear lot lines.

PROPERTY OF  
 ROBERT C. EARLEY & CAROL I. EARLEY  
 NEAR GREENVILLE, S.C.  
 SCALE: 1"=40' 19 JUNE 1986

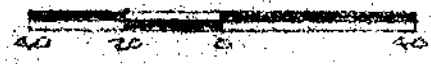

This is to certify that on the 19th day of June, 1986, I surveyed the property shown on this plat, being known as lot 620 on plat of REVISED MAP ONE SECTION THREE SUGAR CREEK and recorded in the RMC Office Greenville County, S. C., in Plat Book "9 & W" at Page 61; and that the property lines, walls and buildings are as shown hereon, and that the walls and buildings located on said lot do not encroach or project on adjacent street or property, and that no adjacent walls or buildings encroach or project on said premises, and no power lines cross this property except as shown hereon.

12-X-48

R. B. Bruce  
 R. B. Bruce

JUL 8 1986

990

R. B. Bruce, RLS # 1952

CAROLINA SURVEYING CO.  
 112 Manly St.  
 Greenville, S.C. 29606

Recordable Plat