


MICROFILMED

FILED
GREENVILLE CO. S.C.
JUL 10 3 57 PM '86
JOHNIE STANKERSLEY
R.M.C.

BARRETT DR.
WATER & SEWER IN ST. RW

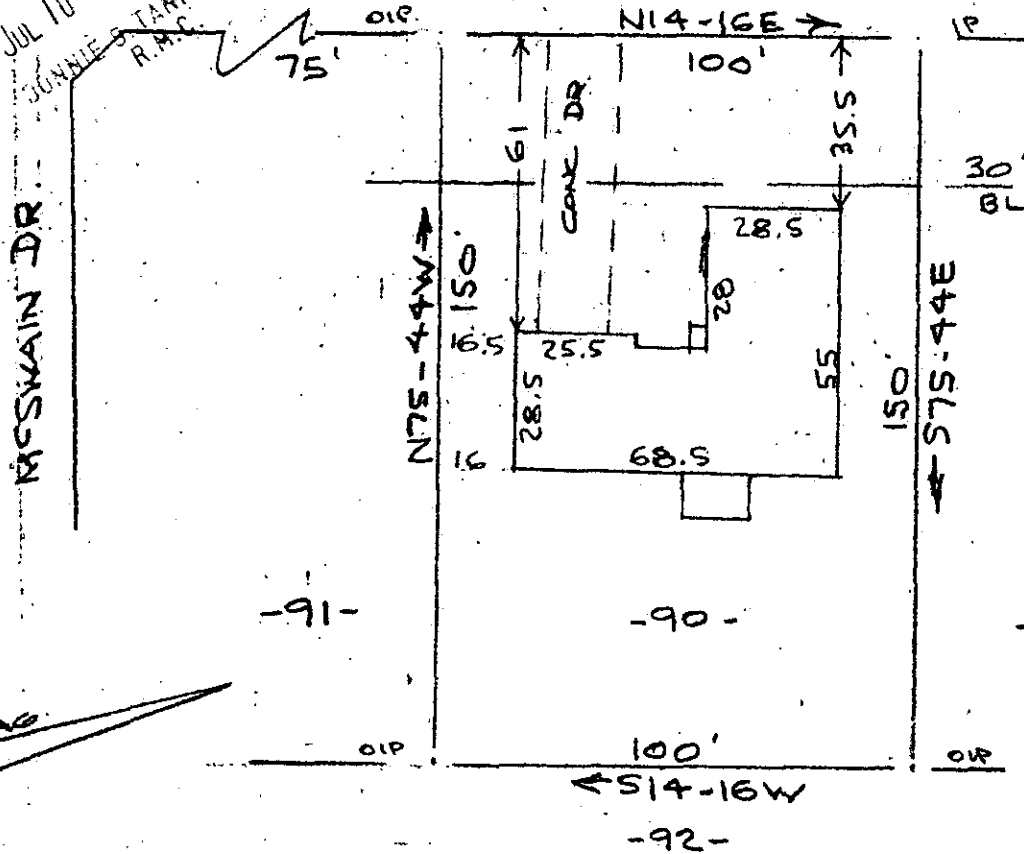

Note:
Improvements on
this lot are not
in a flood
hazard area.

PROPERTY OF
JOAN HAGOOD NORRIS
MAULDIN, S.C.
SCALE 1"=40' 8 JULY 1986

This is to certify that on the 8th day of July, 1986, I surveyed the property shown on this plat, being known as lot 90 on plat of BURDETT ESTATES and recorded in the REC Office Greenville County, S. C., in Plat Book " 5 - D " at Page 71; and that the property lines, walls and buildings are as shown hereon, and that the walls and buildings located on said lot do not encroach or project on adjacent street or property, and that no adjacent walls or buildings encroach or project on said premises, and no power lines cross this property except as shown hereon.

JUL 10 1986 1478

R. B. Bruce
R. B. Bruce
R. B. Bruce, RLS #1952

✓ 12-X-75

CAROLINA SURVEYING CO.
112 Manly St.
Greenville, S. C.

Recordable Plat

3011
2 JUL 10 1986 150
3.0001

224/63

M4.7-1-253

15365