


STANDING SPRINGS ROAD

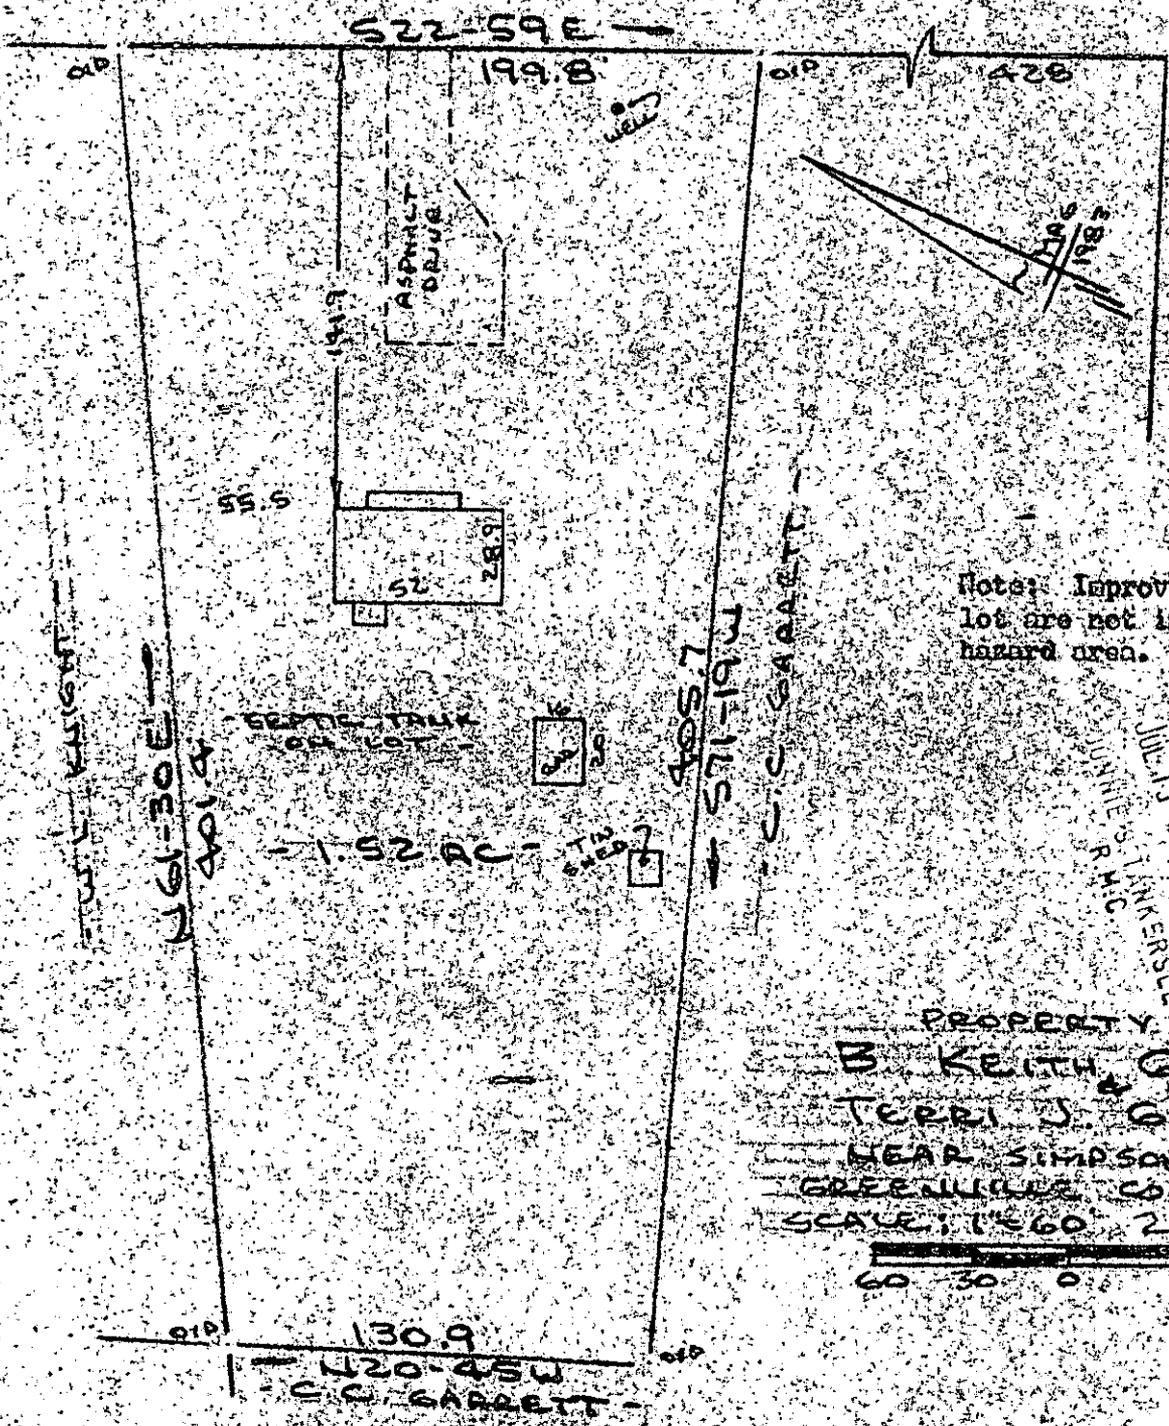

PROPERTY OF  
 B. KEITH GARRETT  
 TERRI J. GARRETT  
 NEAR SIMPSONVILLE,  
 GREENVILLE COUNTY, S.C.  
 SCALE: 1"=60' 27 FEB 1986

This is to certify that on the 27th day of Feb., 1986, I surveyed the property shown on this plat, being known as SURVEY FOR JIMMY M. ADAMS & VIRGINIA W. ADAMS and recorded in the REC Office Greenville County, S. C., in Plat Book "9 - R" at Page 48; and that the property lines, walls and buildings are as shown hereon, and that the walls and buildings located on said lot do not encroach or project on adjacent street or property, and that no adjacent walls or buildings encroach or project on said premises, and no power lines cross this property except as shown hereon.

12-Y-3

JUL 15 1986  
2078 ✓

R. B. Bruce  
R. B. Bruce