MICROFILMED

FILED
GREENVILLE CO. S. C.
JUL 16 2 55 PM '86
DONNIE S. TANKERSLEY
R.M.C.

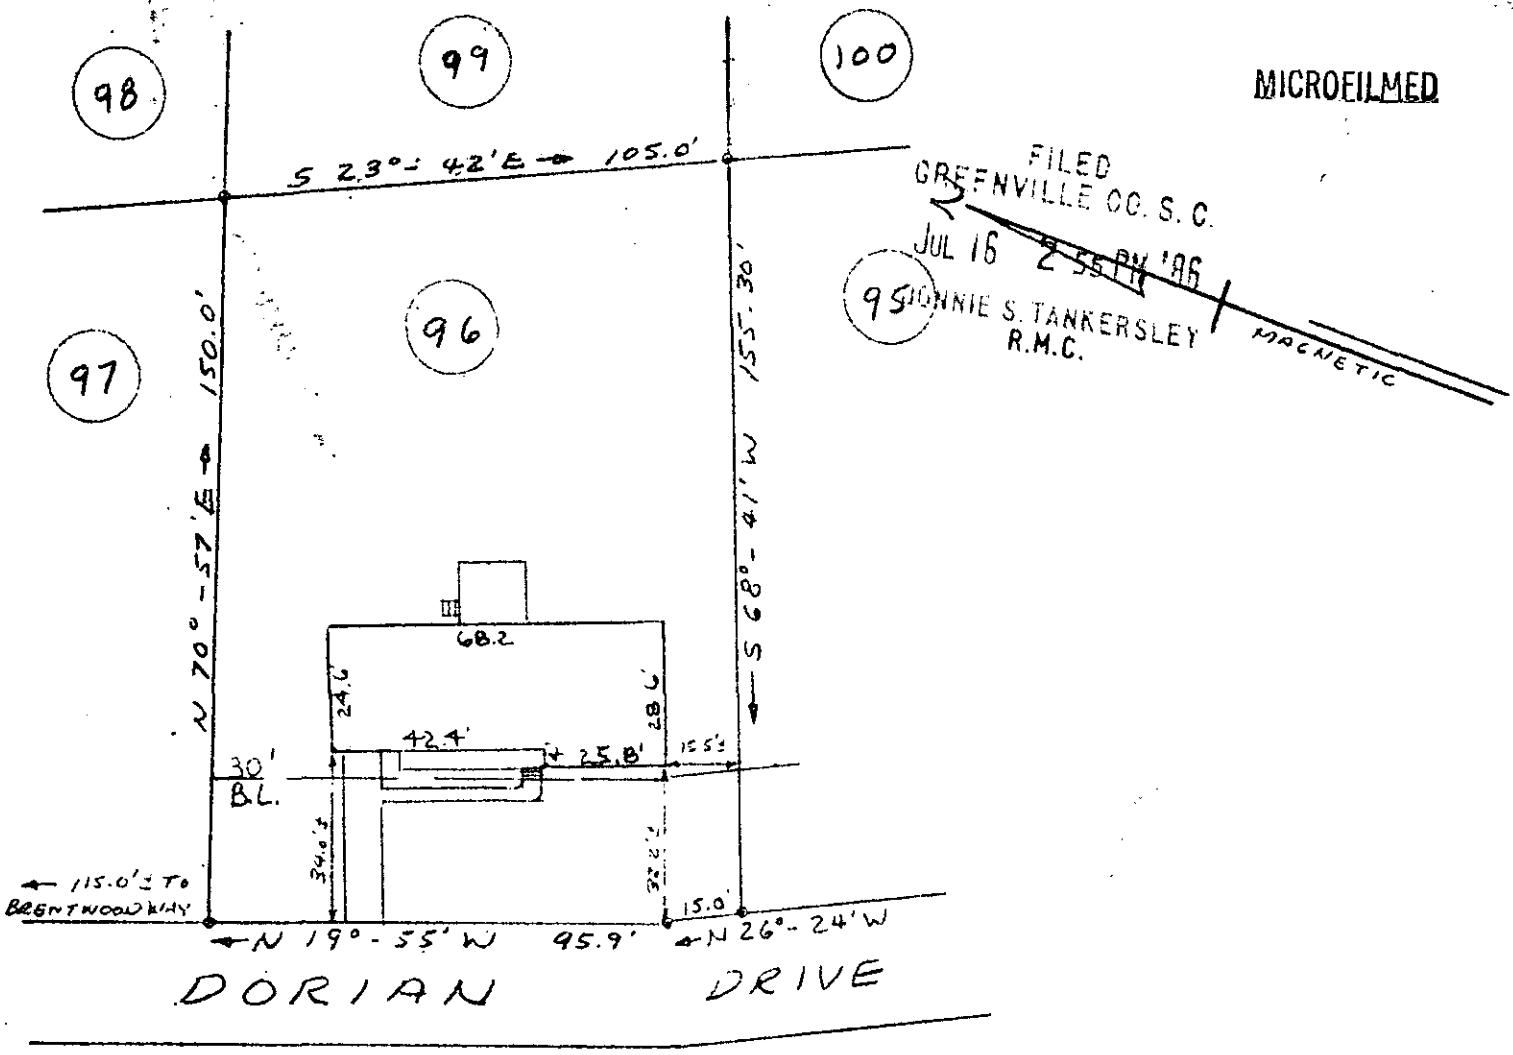

PROPERTY OF

RONALD G. & GAIL P. HALL

NEAR SIMPSONVILLE, GREENVILLE CO., S. C.

July 9, 1986 SCALE: 1" = 40'

This is to certify that on July 9, 1986, I surveyed the property shown on this plat, known as Lot No. 96 of Brentwood, Section III, as shown on a plat recorded in the RMC Office for Greenville County, in Plat Book 5-D, page 42, and that the property lines, walls and buildings are as shown hereon, and that the building located on said lot does not project nor encroach on adjacent streets or property, and that no adjacent walls or buildings project nor encroach on said lot.

2326

NOTE: This property is not located within a flood hazard area.

5 foot drainage easement each side of all side and rear lot lines.

Survey by: Richard D. Wooten, Jr.
Greenville, South Carolina

12-Y-13

Richard D. Wooten Jr.
S. C. R. L. S. No. 4678

JUL 16 1986

Richard D. Wooten Jr.

GCTO -- 3 JL16 86 561 3.00CI

RECORDABLE PLAT