


FILED
 GREENVILLE CO. S.C.
 JUL 17 3 23 PM '86
 JOHNNIE S. TANKERSLEY
 R.M.C.

EDGEWOOD DRIVE

BRADDOCK DRIVE

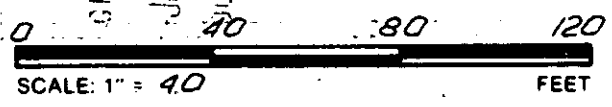

12-Y-30

2483

THIS IS TO CERTIFY THAT THE PROPERTY SHOWN ON THIS PLAT WAS SURVEYED UNDER MY DIRECT SUPERVISION. PROPERTY LINES AND IMPROVEMENTS SHOWN ARE LOCATED CORRECTLY AND THAT NO VISIBLE ENCROACHMENTS EXIST UNLESS OTHERWISE SHOWN. THIS PROPERTY IS NOT LOCATED IN A DESIGNATED FLOOD HAZARD AREA.

SOUTH CAROLINA
 REGISTERED
 PROFESSIONAL
 ENGINEER
 AND
 LAND
 SURVEYOR
 NO. 4781
 JAMES R. FREELAND

RLB: JAMES R. FREELAND
 NO. 4781

STATE OF SOUTH CAROLINA
GREENVILLE COUNTY

KNOLLWOOD HEIGHTS
LOT 8
PROPERTY OF
DEAN E. BISSEY
ELIZABETH W. BISSEY

JUL 17 1986

FREELAND-CLINKSCALES & ASSOCIATES, INC.
 Engineers • Land Surveyors
 323 WEST STONE AVENUE
 GREENVILLE, S.C.
 (803) 271-4924

PLAT BOOK	PPP-6
DEED BOOK	1159-418
TAX MAP	M 8.03-1-38
PARTY CHIEF	J.B.
DRAWN	I.R.
DATE	JULY 1-86
DWG. NO.	156740001