MICROFILMED

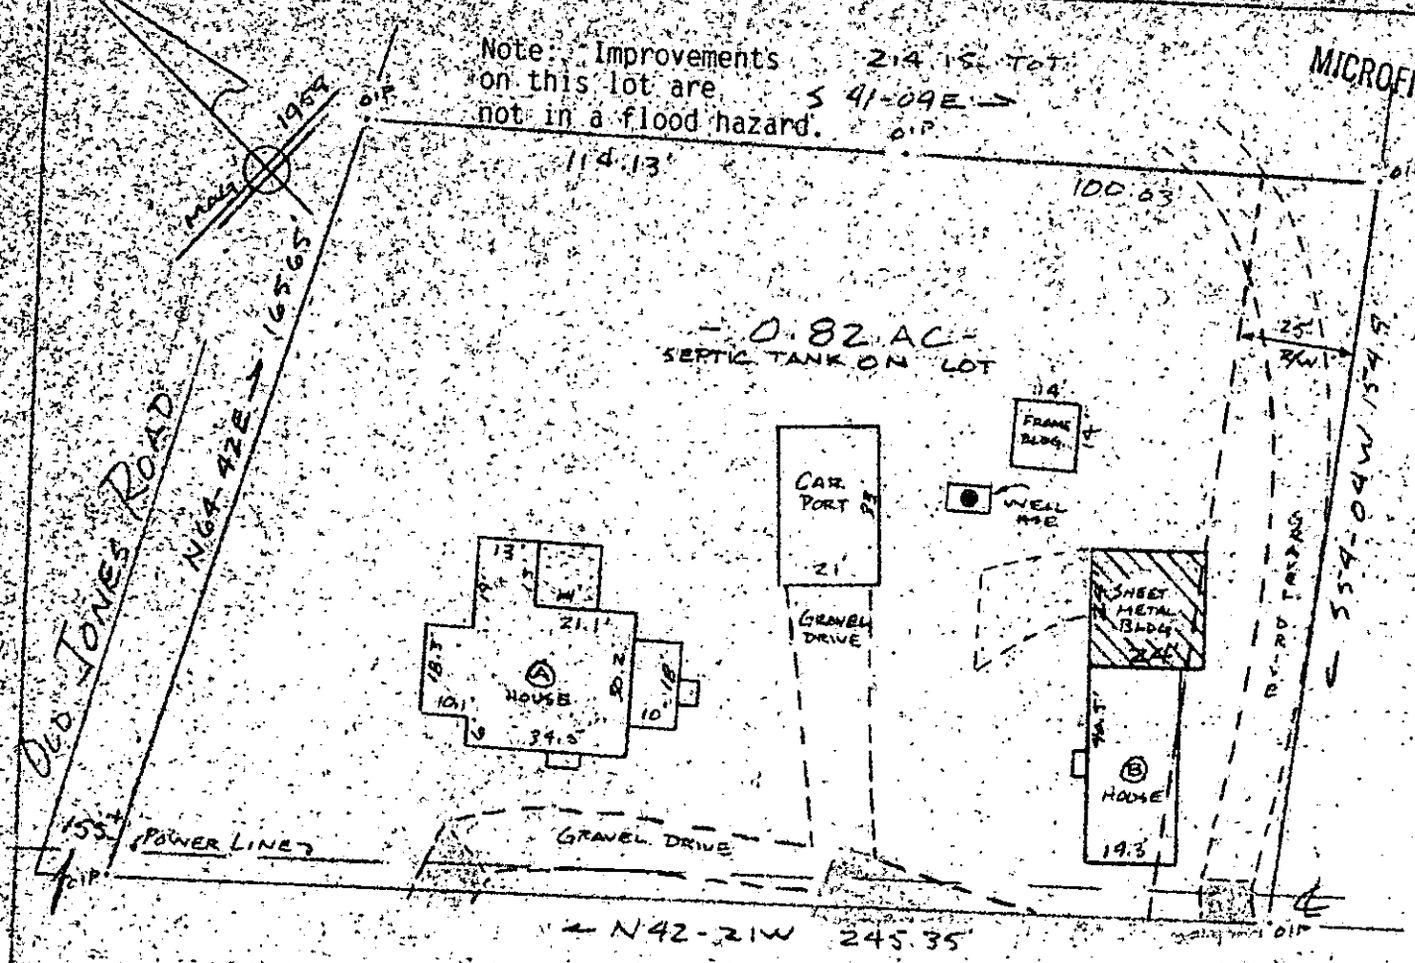

S. C. HWY 253

NOTE: REF. FOR 25' R/W; DEED BOOK 1037 @ P. 304 & PLAT BOOK 8Q @ P. 89. (25' E/W INGRESS & EGRESS

PROPERTY OF

RONNIE W. SHARPE SR. & HARRIETT G. SHARPE

HIGHLAND TOWNSHIP, GREENVILLE CO., S.C.

SCALE 1" = 40'

30 MAY, 1986

0 40 80 120

This is to certify that on the 30th day of May, 1986, I surveyd the property shown on this plat, being known as 0.82 acres on plat of PROPERTY OF RONNIE W. SHARPE, SR. & HARRIETT G. SHARPE and recorded in the RMC Office Greenville County, S. C., in Plat Book at Page and that the property lines, walls and buildings are as shown hereon, and that the walls and buildings located on said lot do not encroach or project on adjacent street or property, and that no adjacent walls or buildings encroach or project on said premises, no power lines cross this property and no visible encroachments except as shown hereon.

FILED
GREENVILLE CO. S. C.
JUL 23 3 43 PM '86
DONNIE S. TANKERSLEY
R.M.C.

12-Y-79

JUL 23 1986

3330

R. B. Bruce

R. B. Bruce, RLS # 1952

CAROLINA SURVEYING CO.
112 Manly St.
Greenville, S. C.

306 1/23

6449-3-2 JL23 86 1206 3.00CI