MICROFILMED

Note: Improvements on this lot are not in a flood hazard area.

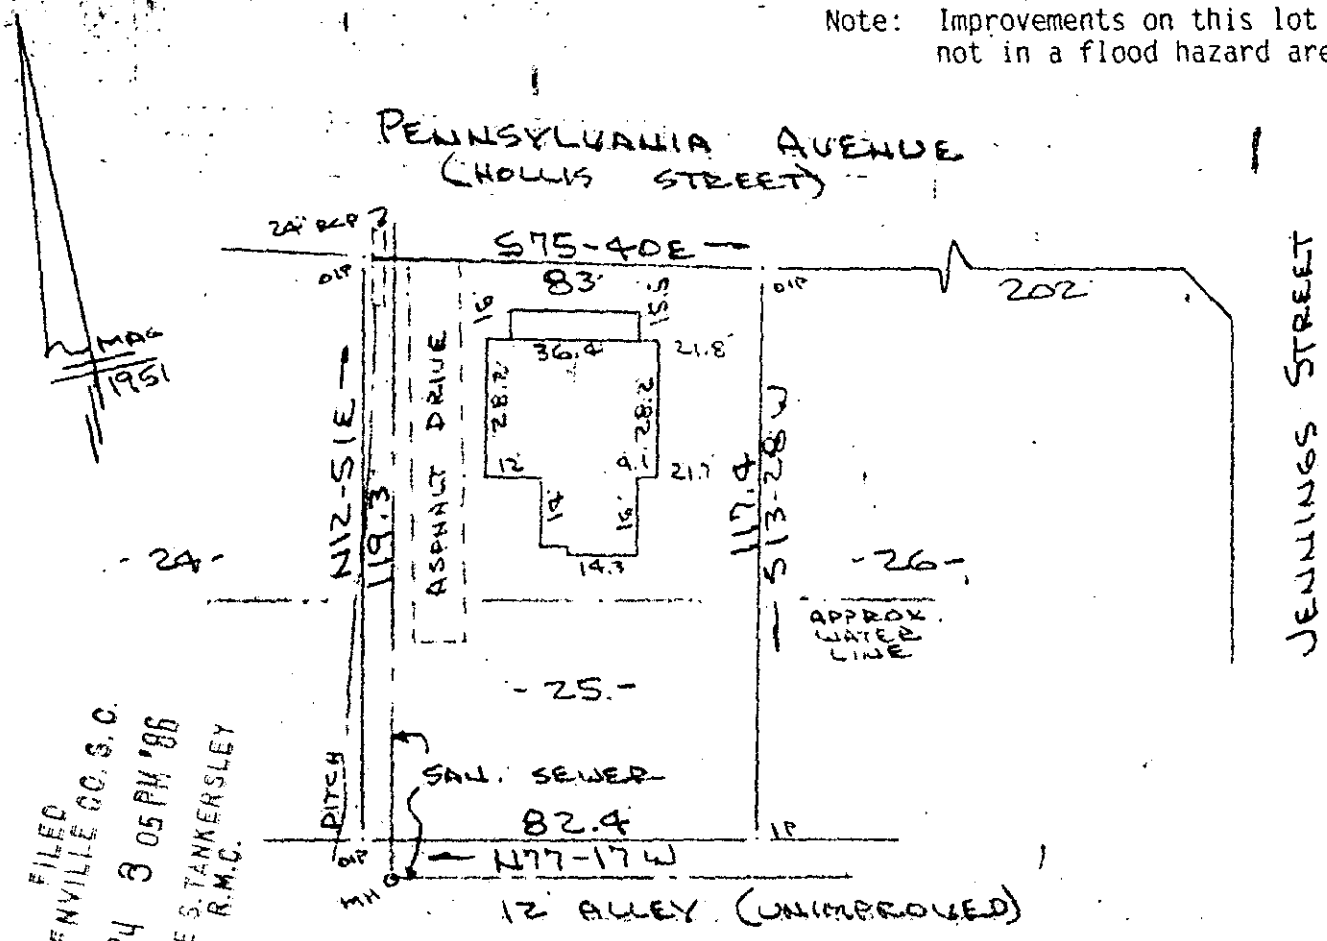

FILED
GREENVILLE CO. S.C.
JUL 24 3 05 PM '86
DONNIE S. TANKERSLEY
R.M.C.

PROPERTY OF
JEFF S. HOWELL & RHONDA B. HOWELL
GREENVILLE CO., GREER, S.C.
SCALE: 1"=40' 21 JULY 1986

40 20 0 40

This is to certify that on the 21st day of July, 1986, I surveyed the property shown on this plat, being known as lot 25 on plat of GREER MILL VILLAGE and recorded in the RMC Office Greenville County, S.C., in Plat Book " Y " at Pages 138 & 139; and that the property lines, walls and buildings are as shown hereon, and that the walls and buildings located on said lot do not encroach or project on adjacent street or property, and that no adjacent walls or buildings encroach or project on said premises, no power lines cross this property and no visible encroachments except as shown hereon.

3523

R. B. Bruce

R. B. Bruce, RLS #1952

12-Y-96

JUL 24 1986

CAROLINA SURVEYING COMPANY
112 Manly St.
Greenville, S.C.

Recordable Plat

RECD JUL 24 86 172 3.00CD