


FILED
GREENVILLE CO. S.C.
JUL 24 11 28 AM '86
JOHNNIE S. TANKERSLEY
R.M.C.

Note: Improvements on this lot are not in a flood hazard area.

JUL 24 1986

12-2-25

PROPERTY OF
JAMES S. HUNT & MARY L. HUNT ✓ 3532
NEAR GREENVILLE, S.C.
SCALE: 1"=50' 15 JULY 1986

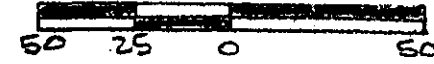

This is to certify that on the 15th day of July, 1986, I surveyed the property shown on this plat, being known as lot 4 (2.30 acres) on plat of SHELLEY CONSTRUCTION & REALTY CO. and recorded in the RMC Office Greenville County, S.C., in Plat Book " 7-C " at Page 43; and that the property lines, walls and buildings are as shown hereon, and that the walls and buildings located on said lot do not encroach or project on adjacent street or property, and that no adjacent walls or buildings encroach or project on said premises, no power lines cross this property and no visible encroachments except as shown hereon.

R. B. Bruce
R. B. Bruce, RLS #1952

CAROLINA SURVEYING COMPANY
112 Manly St.
Greenville, S.C.

Recordable Plat

GOTO 2 JUL 24 86 1319

5.00CI