


40.00
27
12

Mrs. Lewis Property

W. 27th Street
60' wide
S 63 E

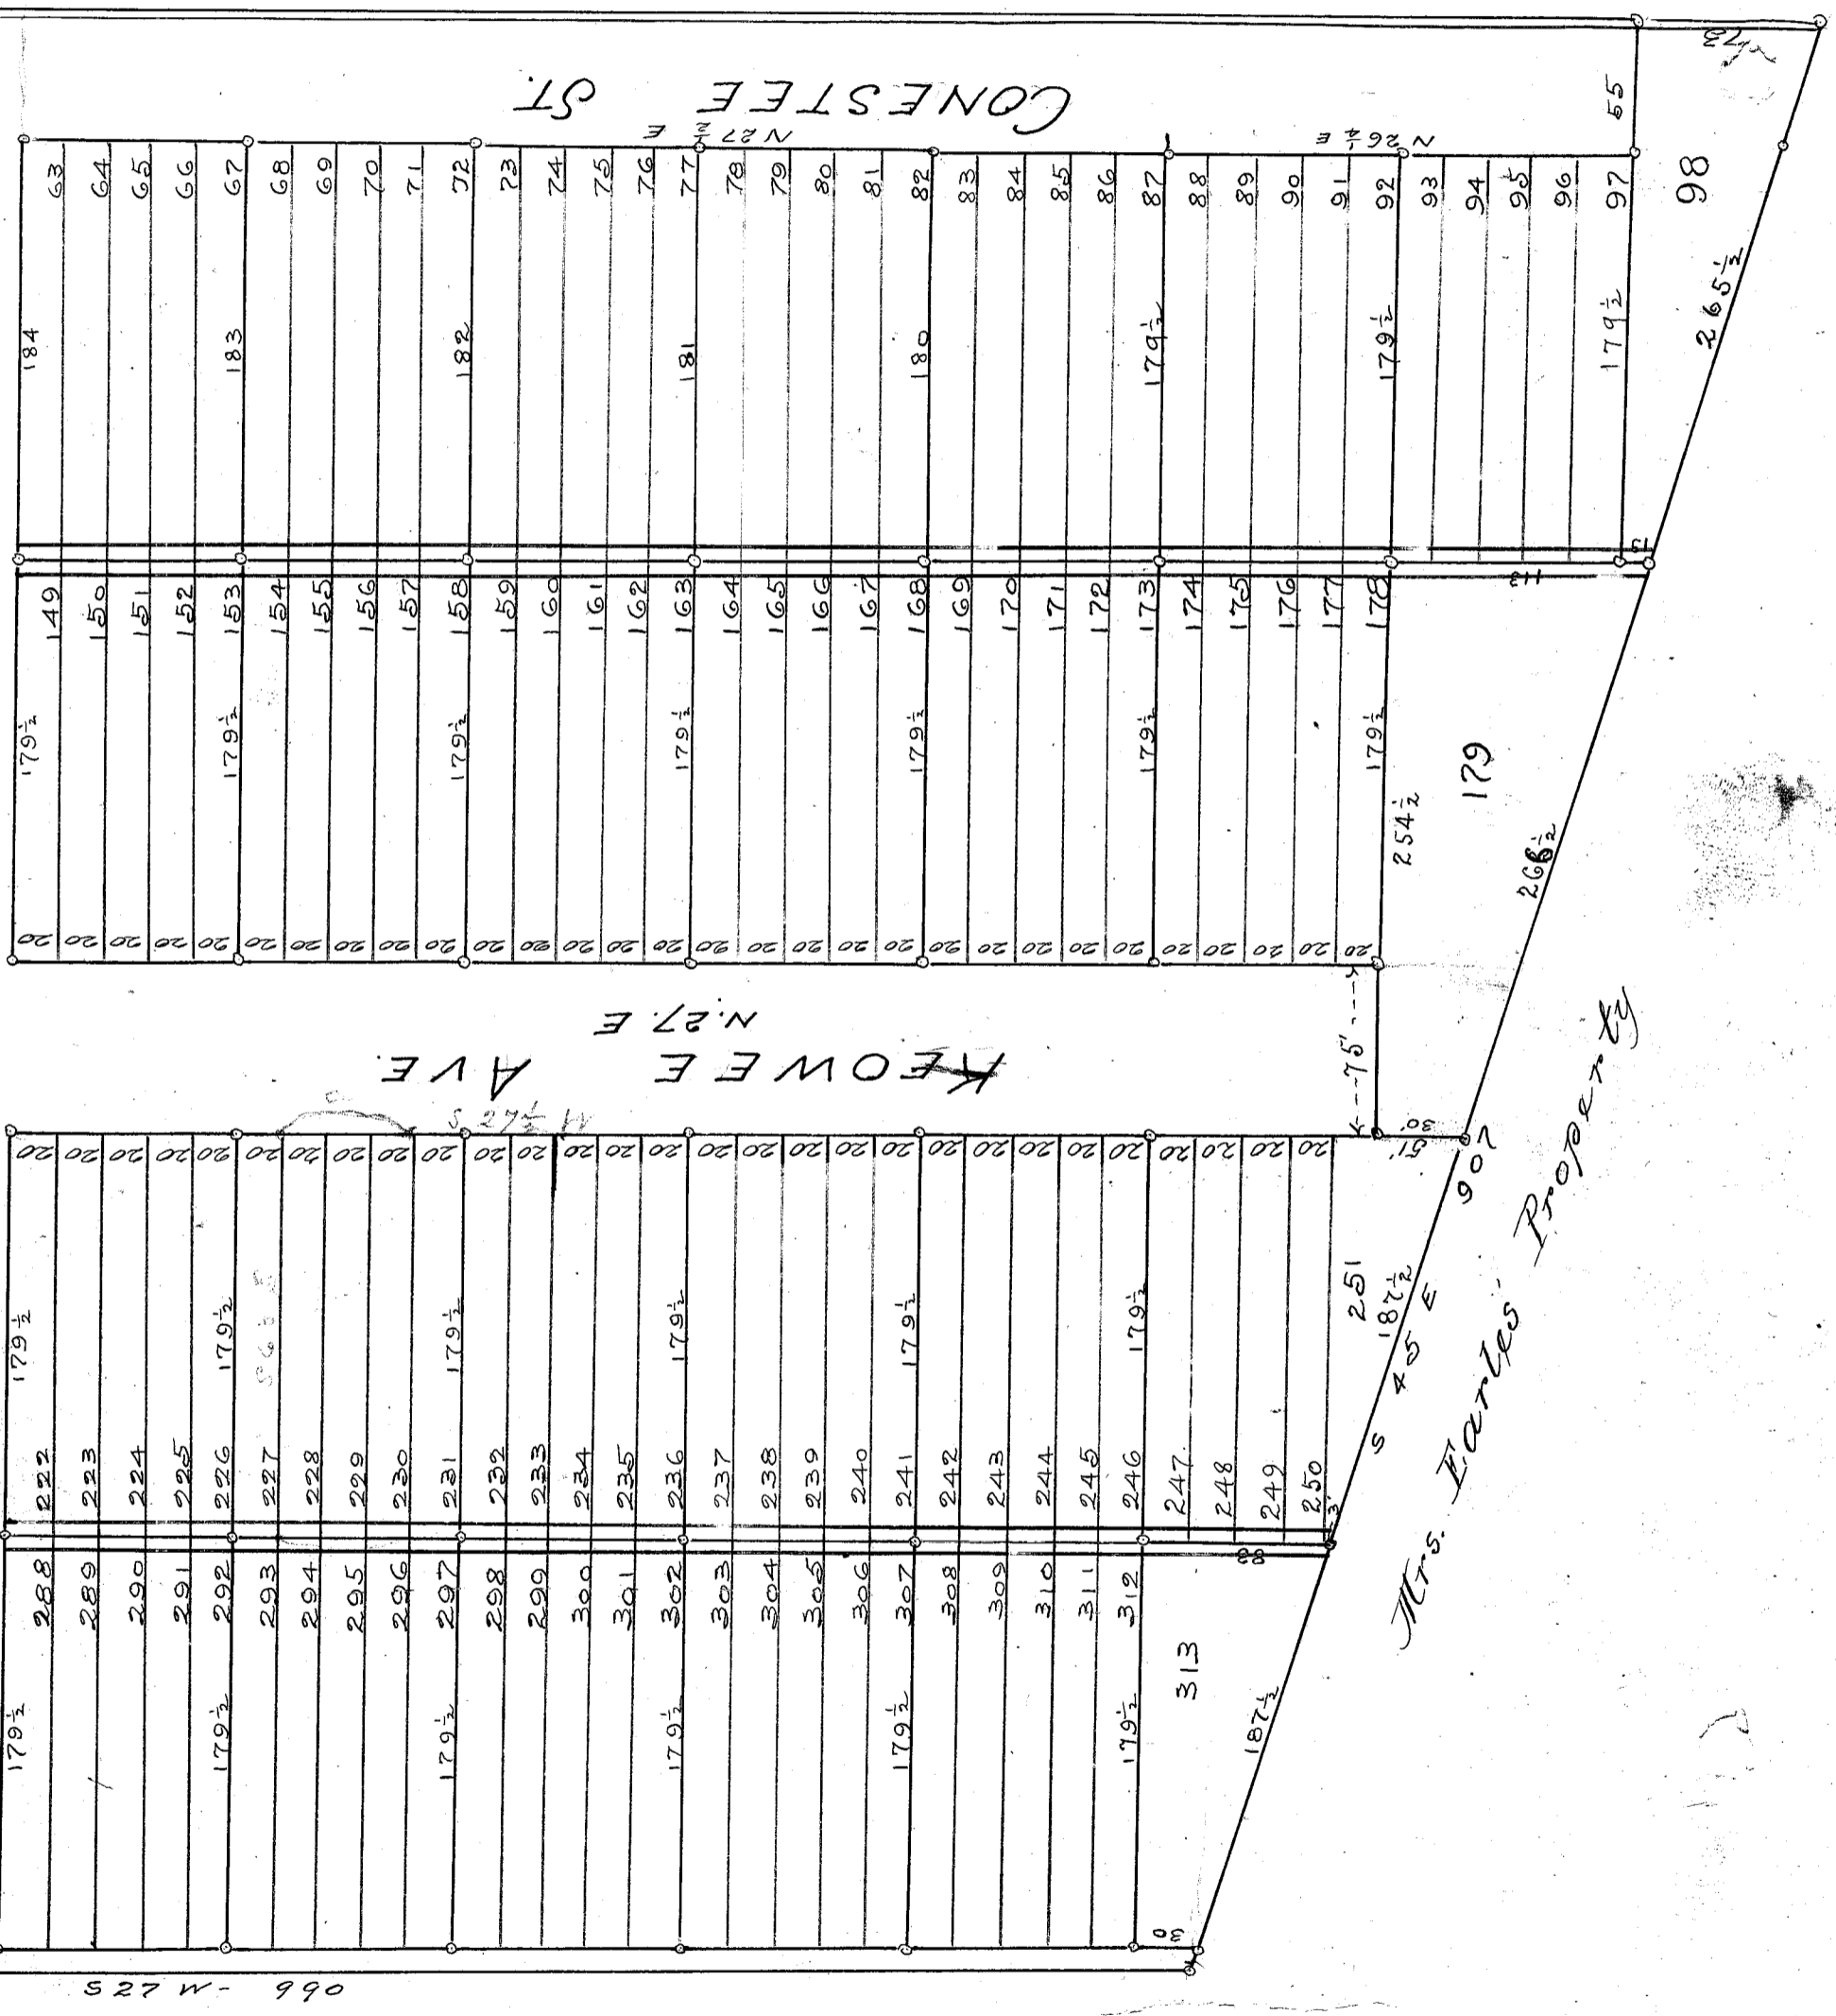

Mrs. Farley's Property

This portion of "Cherokee Park" is now called "South Cherokee Park" and the arrangement of lots is changed. See page 100 - this book. The position of the st. has not been altered.

S 27 W - 990