

See page 217 in this book


NOTE: - THIS MEASUREMENT SHOULD BE 35' 0" Surveyed Feb-28-1913 F.S. Brown

HUNT ST. EXT. HAMILTON AVE. TO BRIDGE

SW. A. 217

DONALDSON

Extension of Hamilton Ave. ST. CLAIR ST.

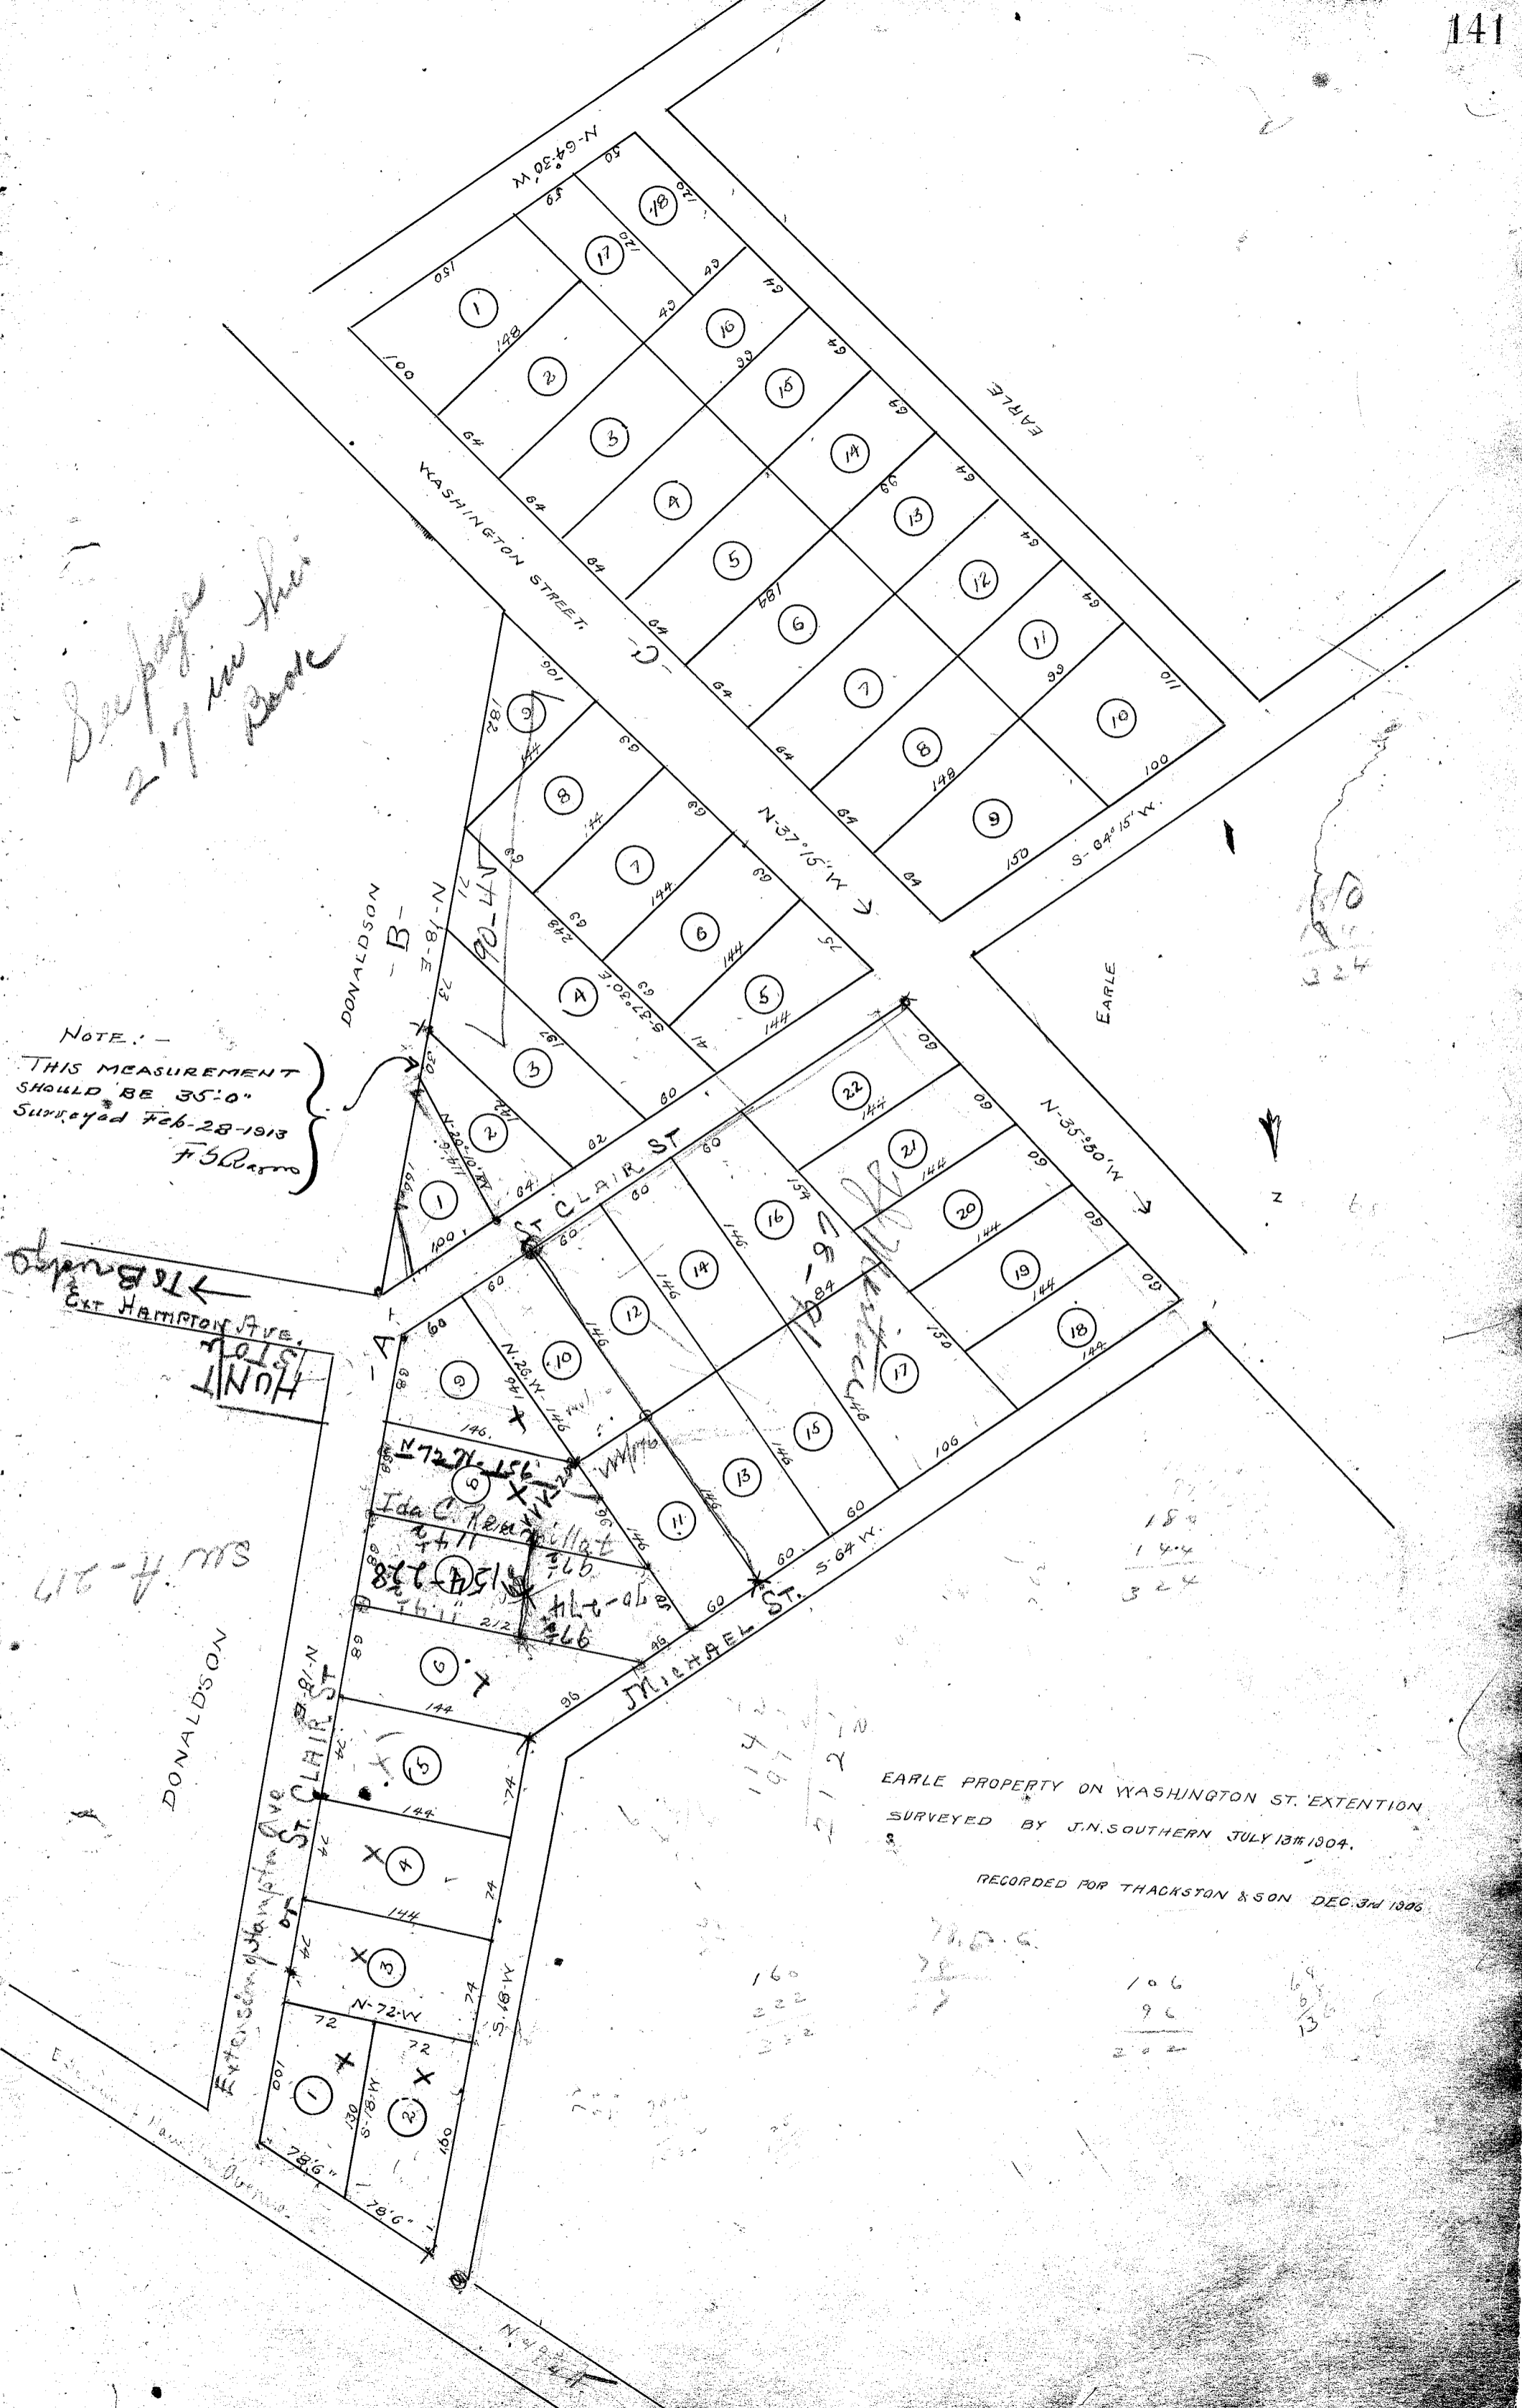

EARLE PROPERTY ON WASHINGTON ST. EXTENTION SURVEYED BY J.N. SOUTHERN JULY 13th 1904.

RECORDED FOR THACKSTON & SON DEC. 3rd 1906

106
96
207

13

1142
197
212