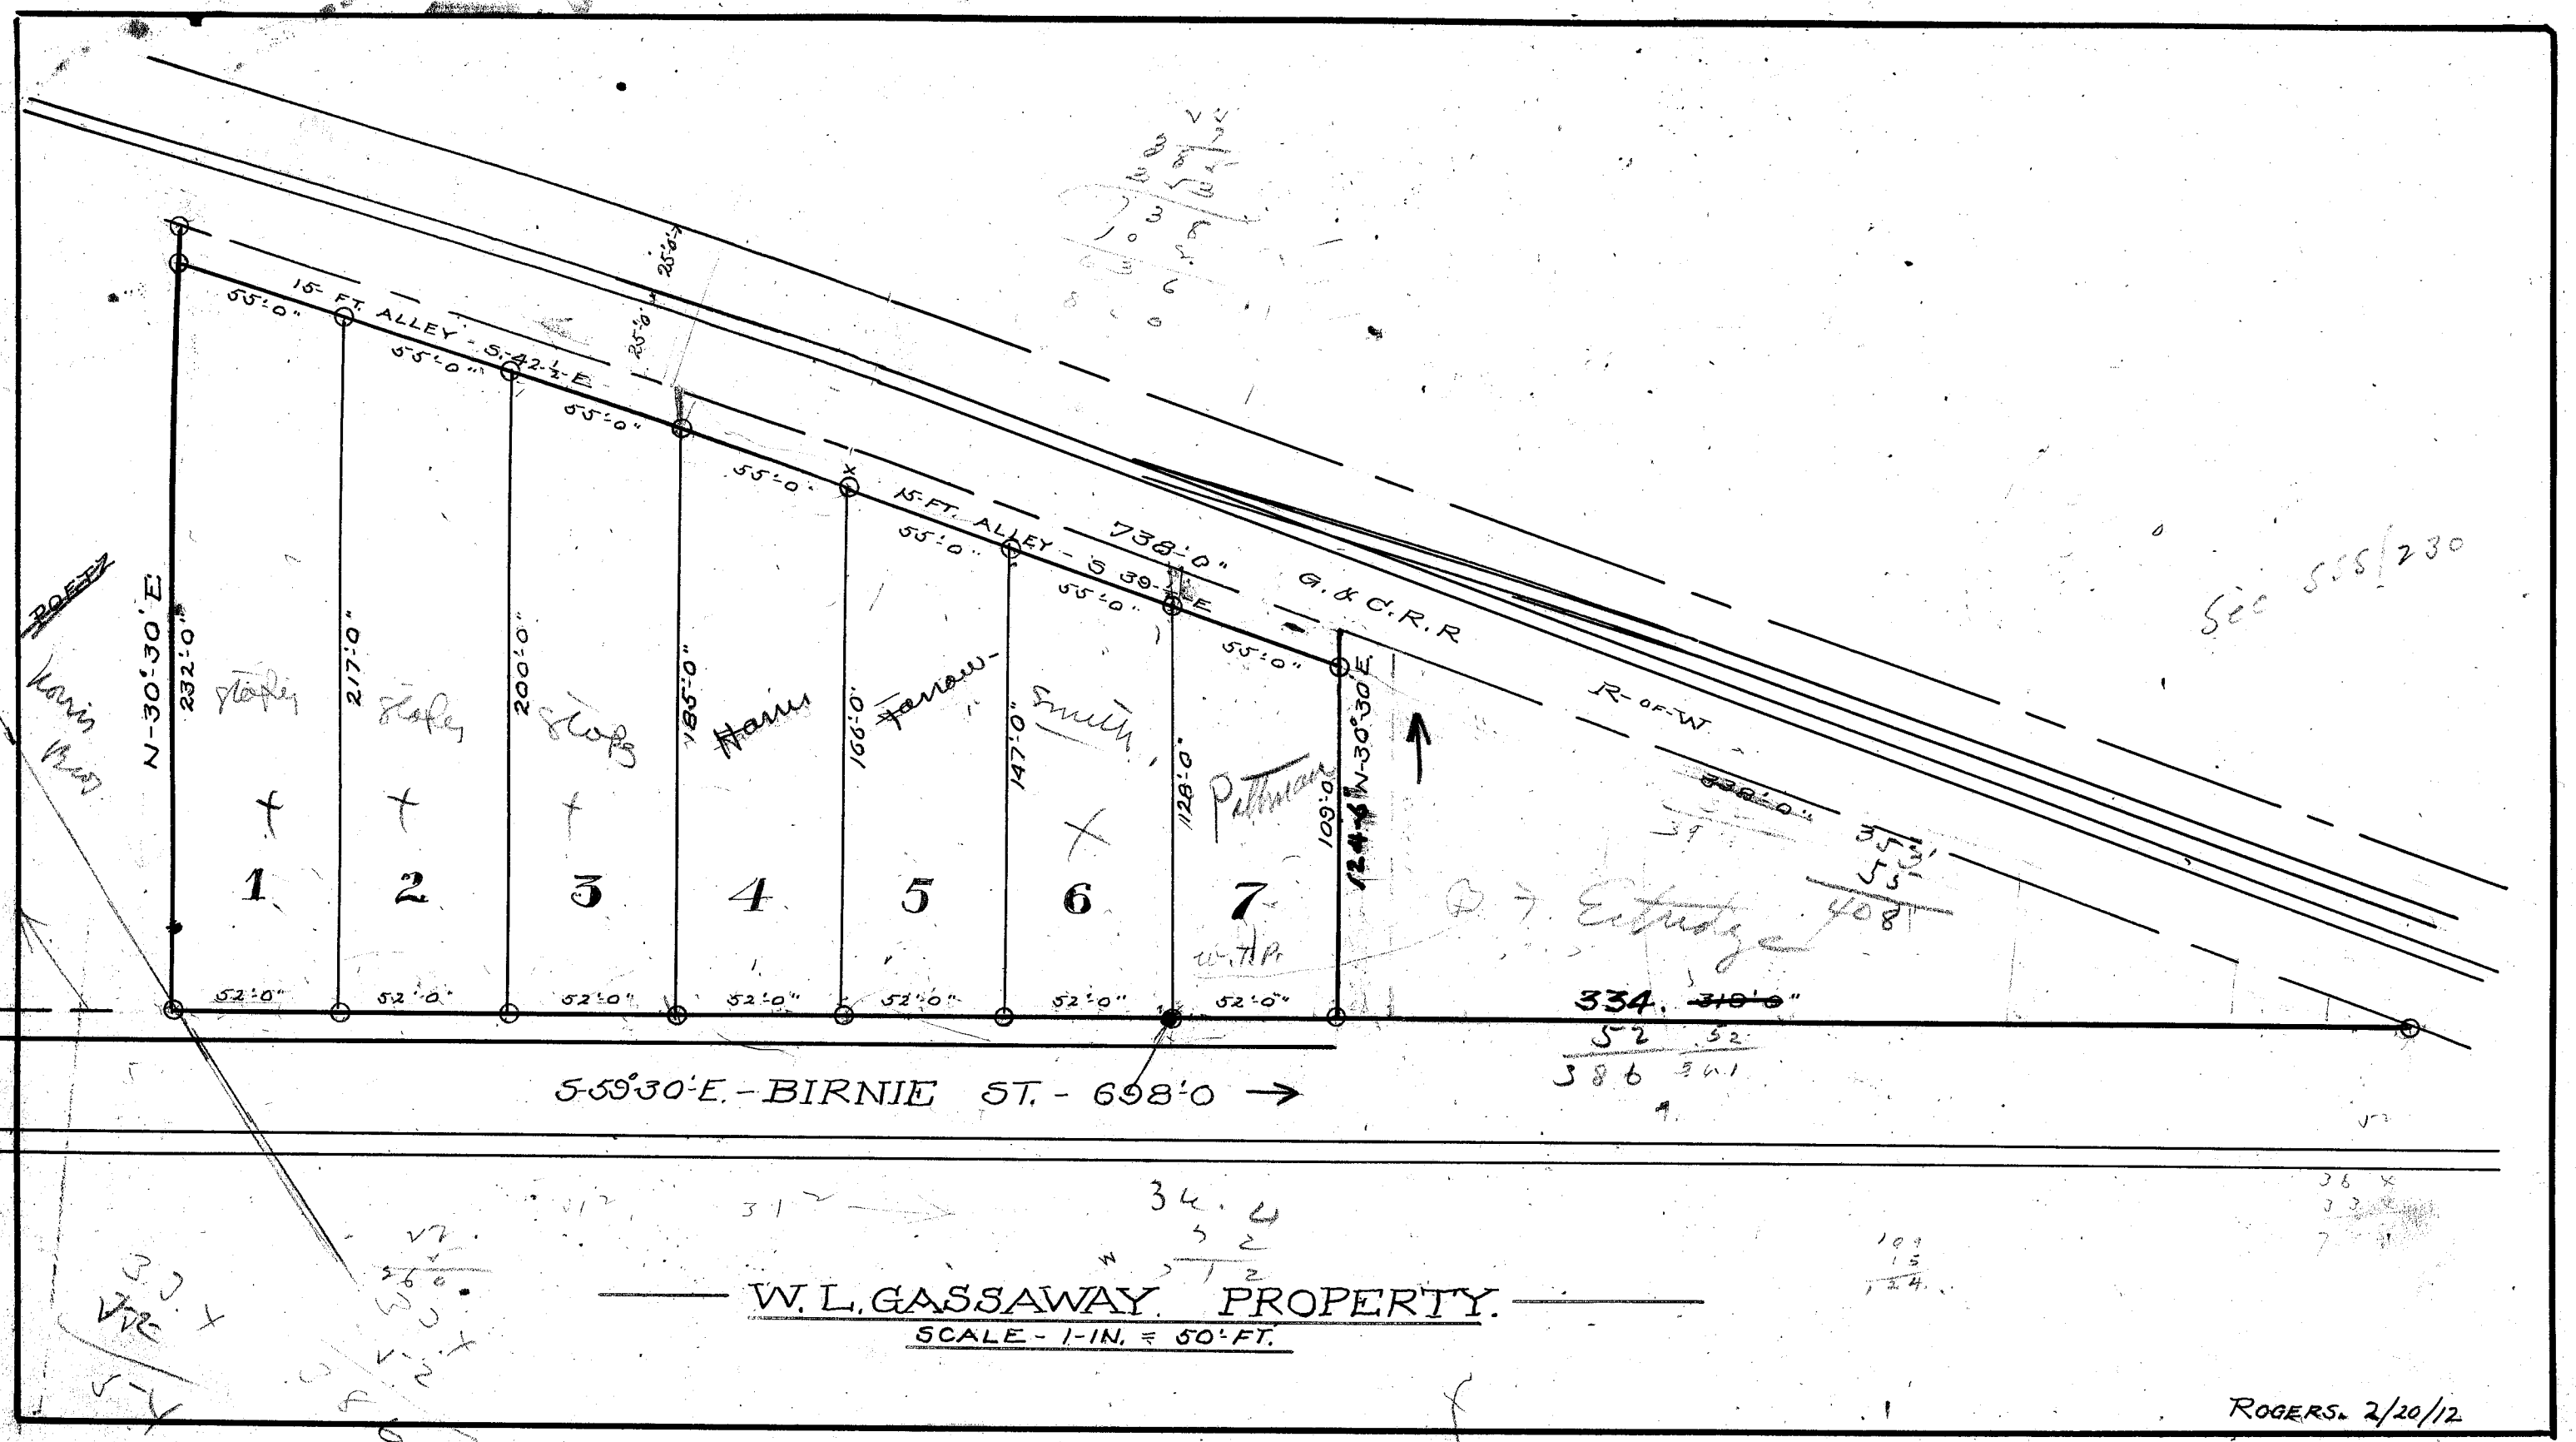
15-FT ALLEY - S.42½-E.
15-FT. ALLEY - S 39-E
738'-0"
G. & C. R. R
R-OF-W
N-30°-30'E
232'-0"
217'-0"
200'-0"
185'-0"
166'-0"
147'-0"
128'-0"
109'-0"
S-59°30'-E.-BIRNIE ST.-698'-0
1
2
3
4
5
6
7
52'-0"
55'-0"
W. L. GASSAWAY PROPERTY.
SCALE - 1-IN. = 50'-FT.
ROGERS. 2/20/12