


128

This land is owned now by Tindal. W. W.

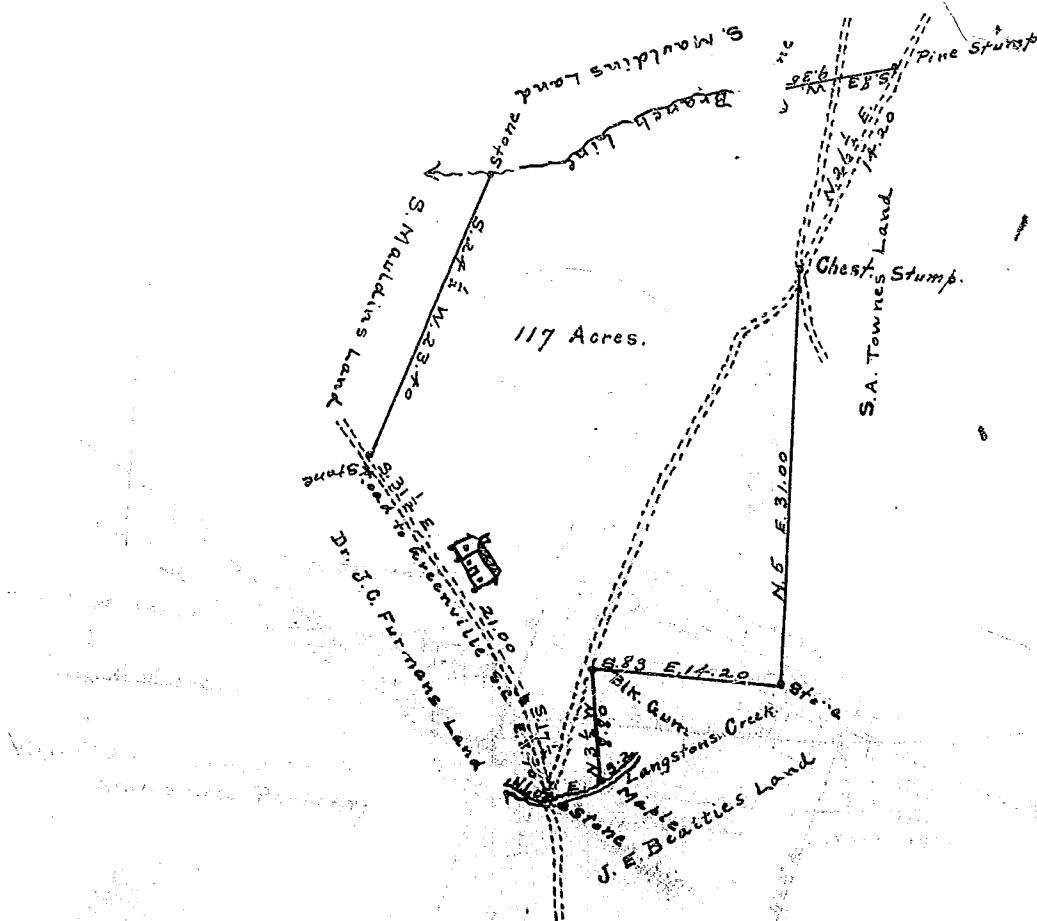

Scale at ten chains per inch.

South Carolina,

County of Greenville,

By request of Rev. J.C. Furman, D.D. I have resurveyed the above tract of land, known as the Pettis W. Chick land, situated 4 miles from Greenville C.H. on waters of Langstone Creek or Reedy River and hath such form, marks, boundaries &c. as shown by the above plat.

Resurveyed Jany. 20th. 1899.

Wm. A. Hudson.

Recorded for March 25th, 1914.

U.S.

and copied by James P. Bates.