


1441
 Note:- Lines "A" & "B" were changed June 1912 by request
 of owner by R.E. Dalton on Survey of adjoining property.
 Lots No. 41, 42, 43, 58 & 60 were discontinued from this
 plan at same date.

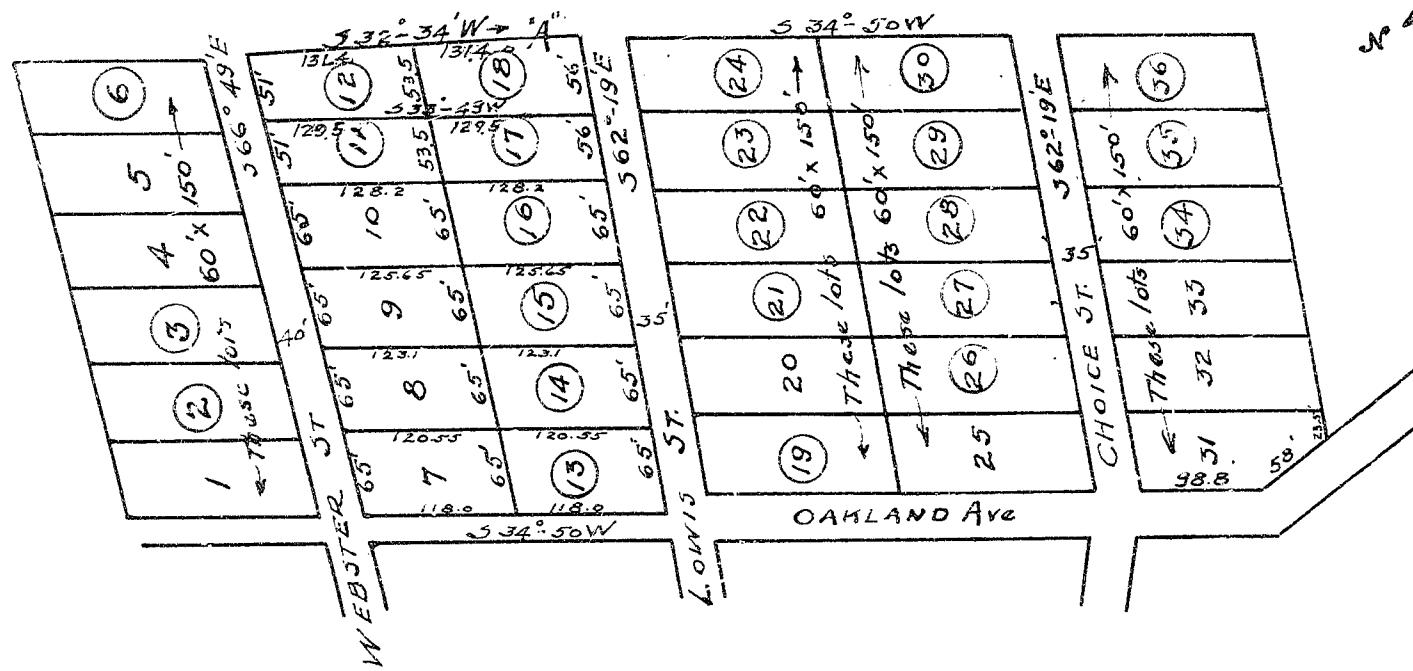

The Red Circles indicate the 24 lots conveyed to
 F.W. Symmes - W.D. Parrish & T.C. Gower by W.C. Cleveland
 by deed dated April 16th 1914 and recorded in
 the R.M.C. office for Greenville County.

Plot of
 Oakland Heights
 Property of
 W. C. Cleveland
 Cleveland & Williams, Agts.

Scale: 1"-100'