State of S. C. - Greenville Co.
The above plat represents a tract of land belonging to Est. of R. Mays Cleveland, Deceased, lying on Fall Creek & waters of Gap Creek of Middle Saluda River at the request of J. Norwood & R. Mays Cleveland, Jr., I have surveyed the Eastern & Southern boundry of said tract and taken the Original survey of State line between North & South Carolina as the Northern Boundary and Fall Creek as Western Boundry of said Tract. I find the same to contain Sixteen Hundred (1600) Acres, more or less, with such marks and Bounds as is represented by the above Plat. Surveyed by Alonzo. L. Edens, Ending November 28th, A.D. 1916.
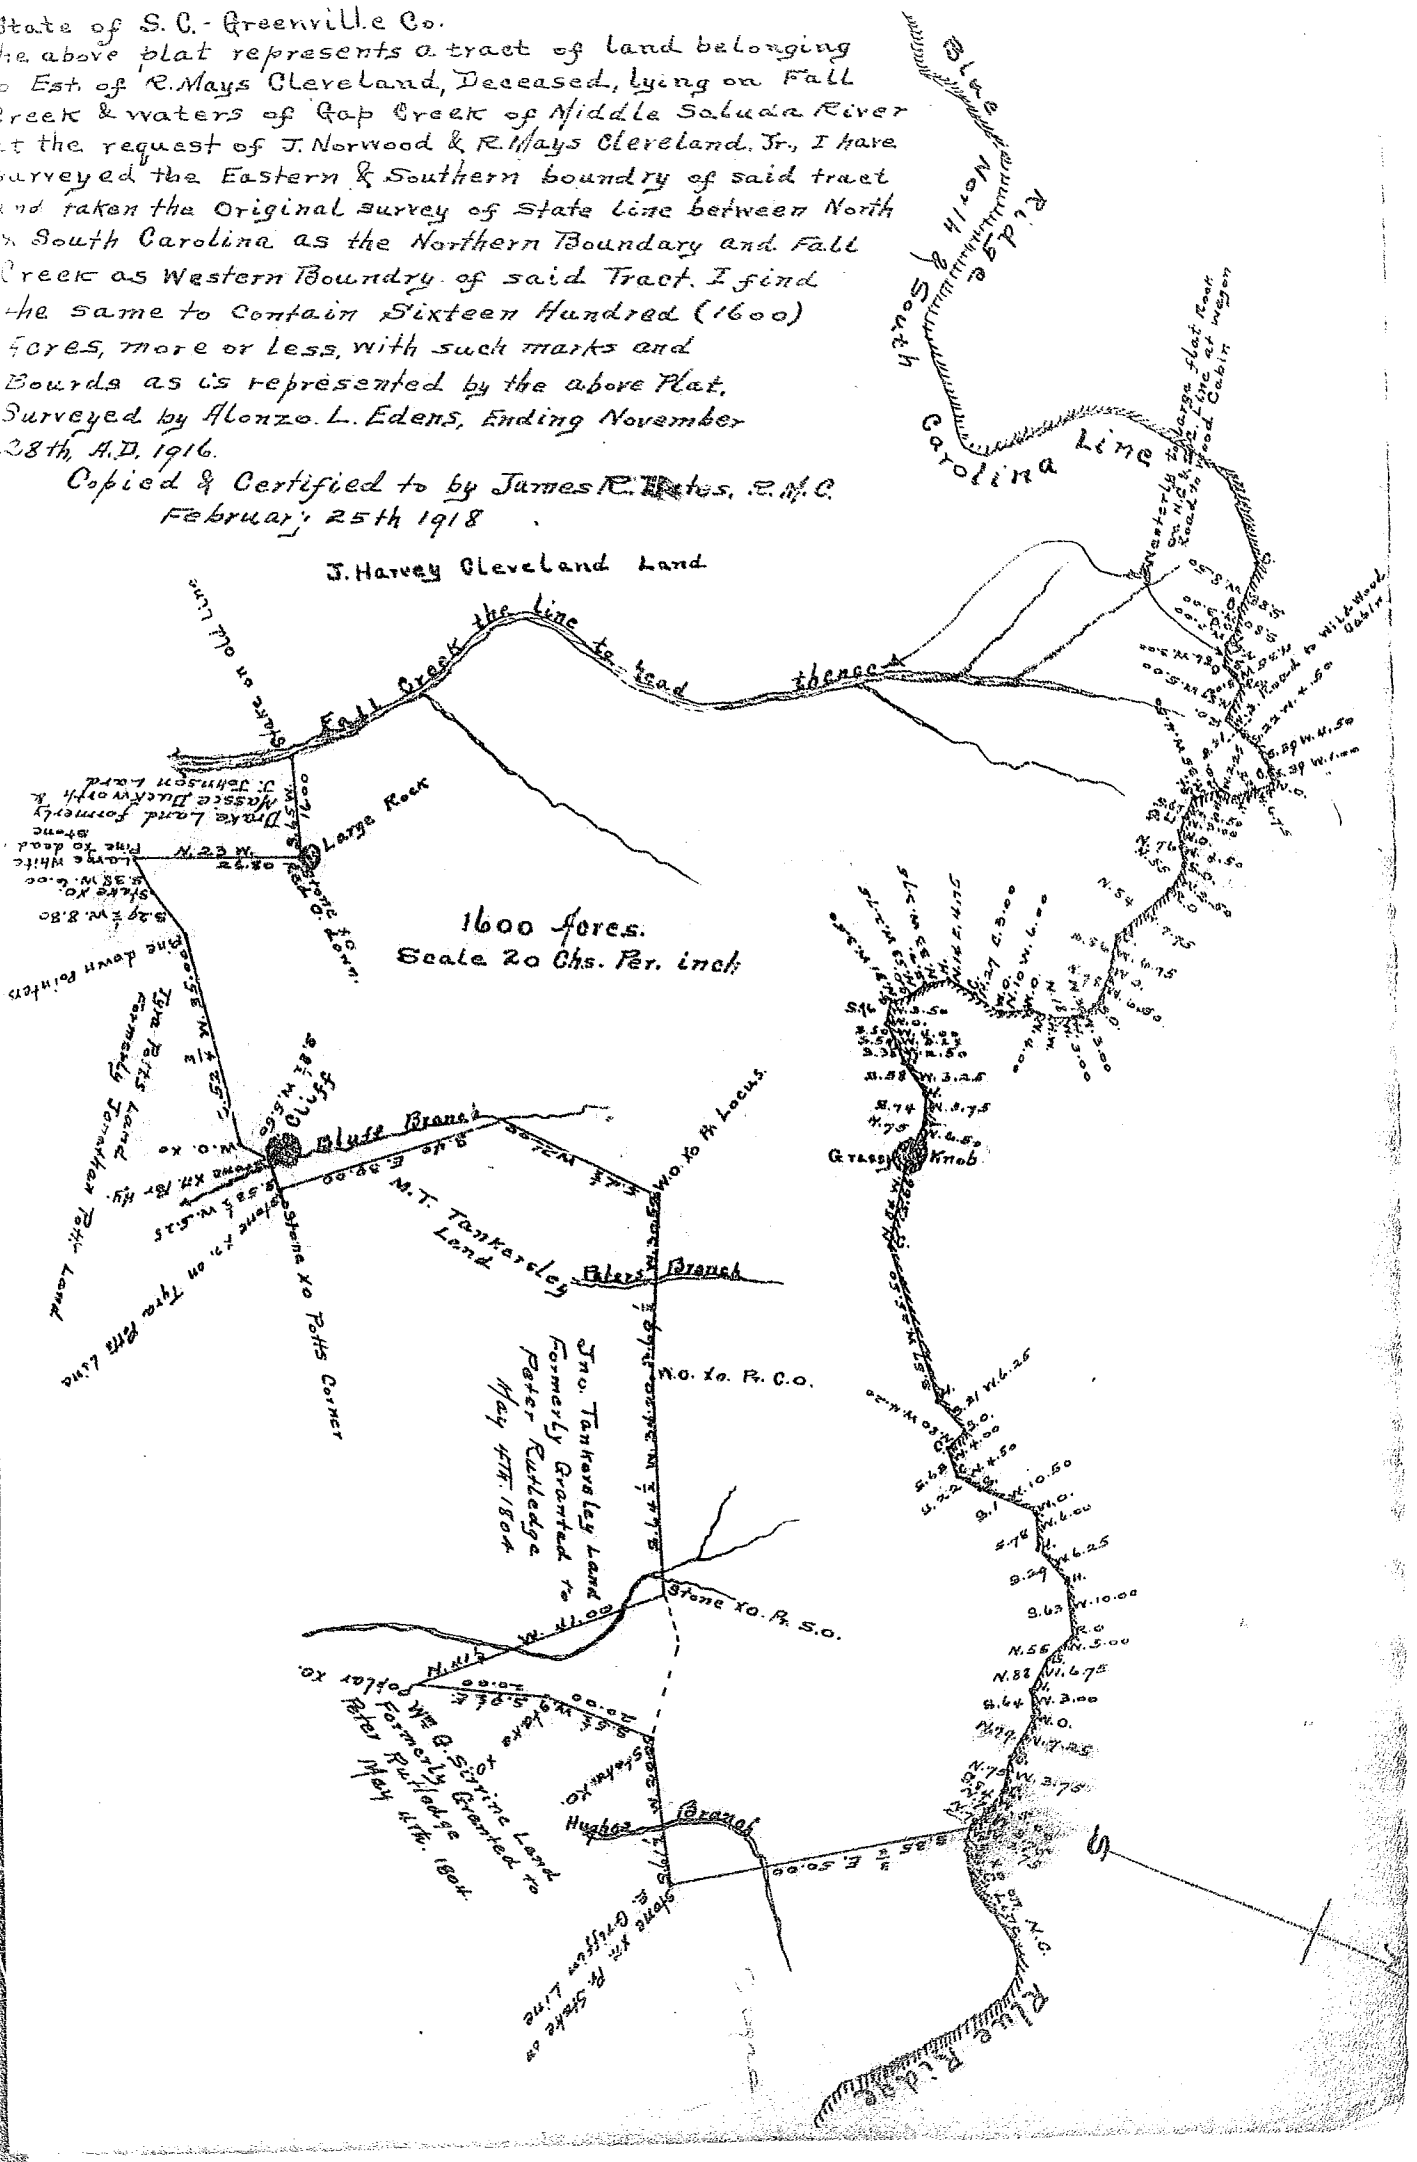
Copied & Certified to by James R. Hayes, C.M.C. February 25th 1918