

NOTE -
REVISION OF LOTS 12, 3, 4, 5, 6
BLOCK "E", PAGE 102

RECORDED DEC. 16, 1924 BY C. PULLARO

N. MAIN ST. (Revised)

HILL CREST DRIVE

STREET

FAIRVIEW AVE.


HILL CREST DRIVE

MAUTAUGA STREET

CLINTON STREET

For Land West of this
See Preceding pages.

BAD COPY

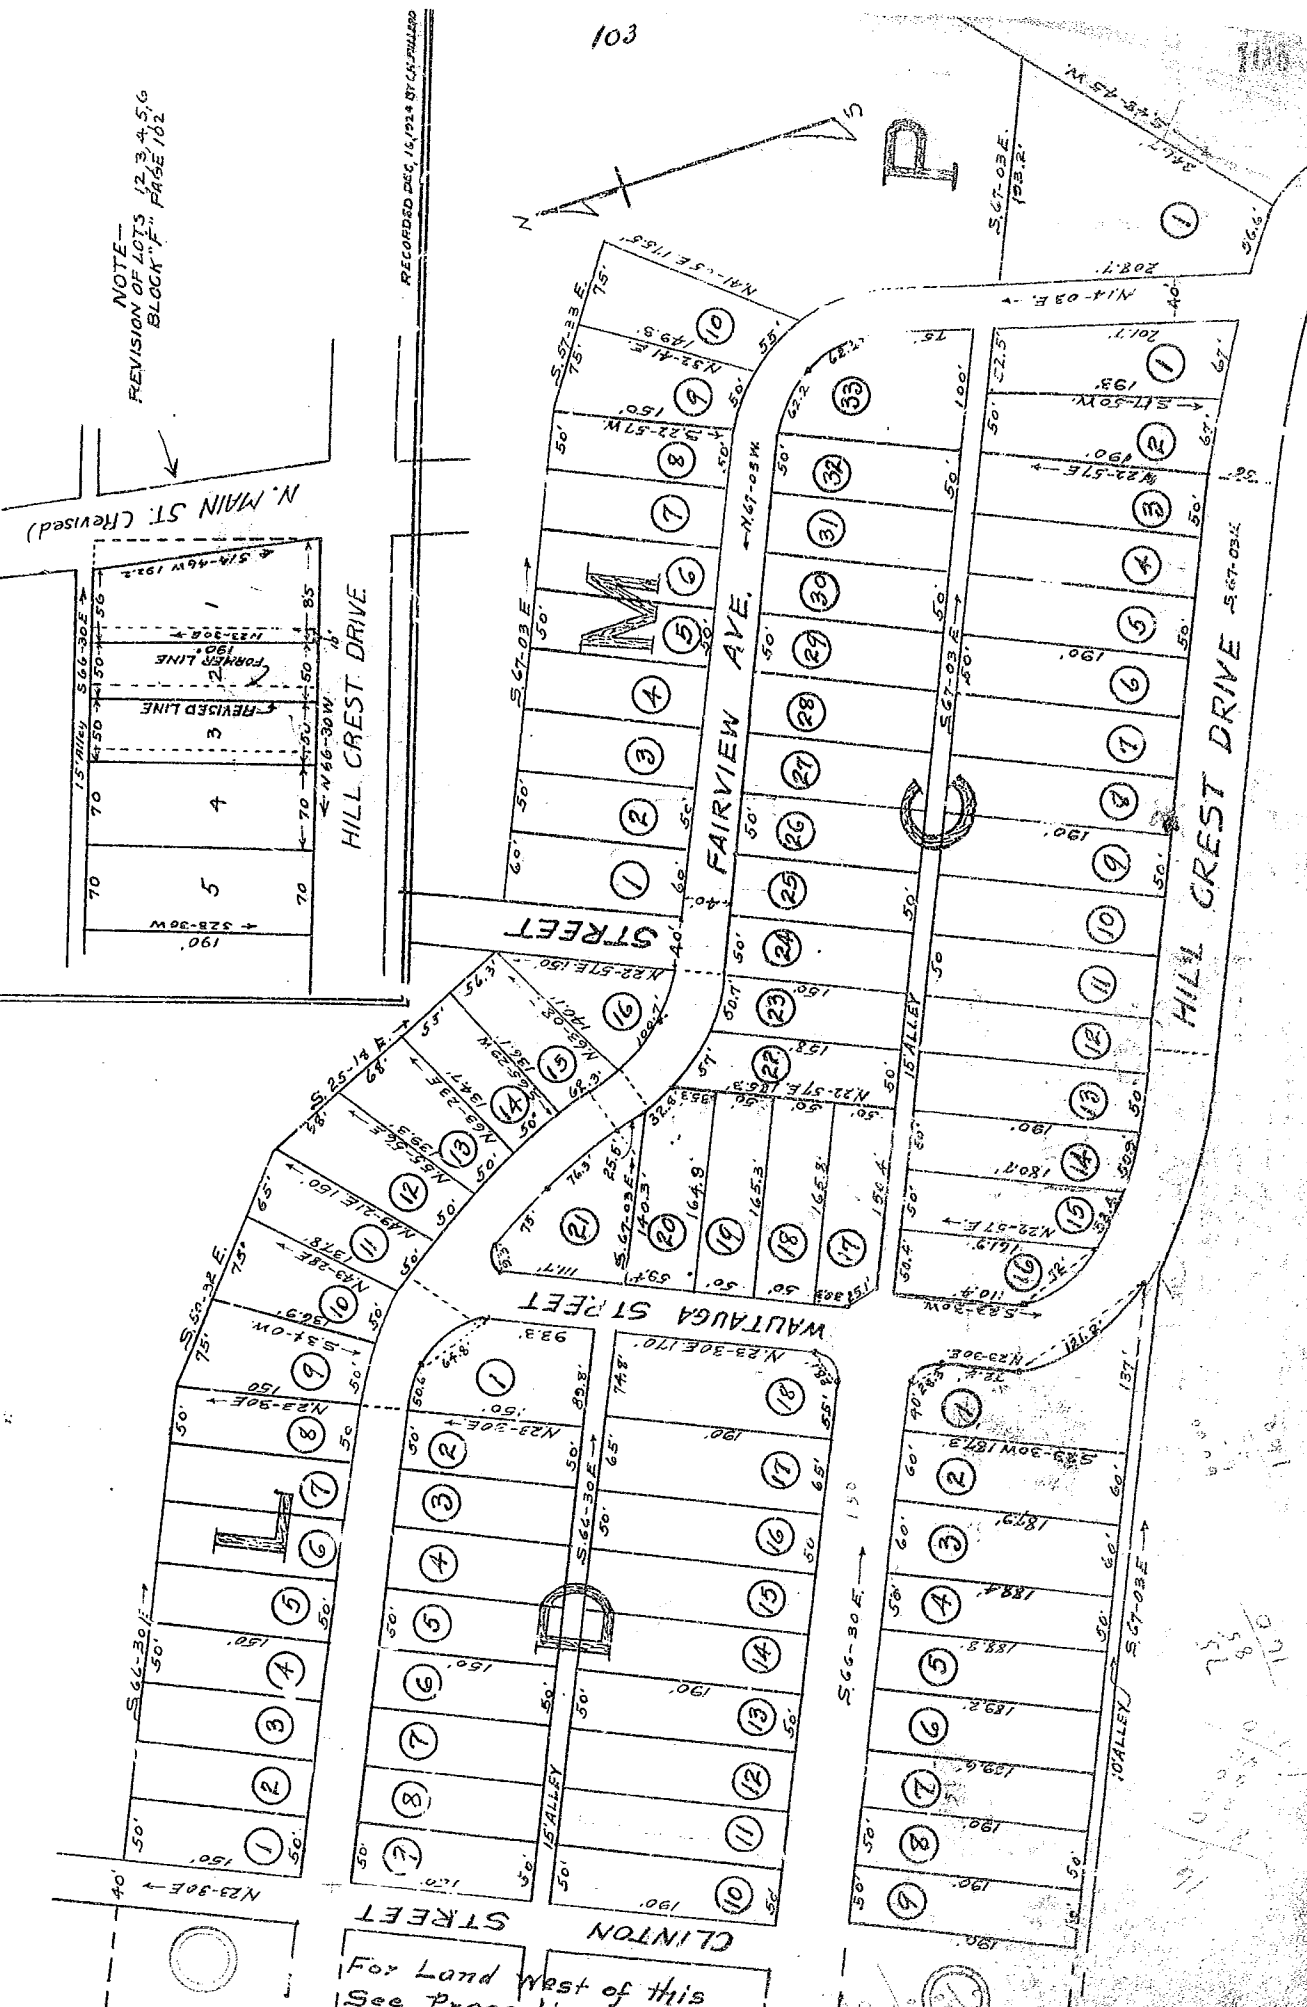

75
50
100