


PROPERTY OF
 E. M. BLYTHE
 GREENVILLE CO. S. C.
 Scale 1" = 600' - Jan. 1920.

FORMERLY PROPERTY OF
 TULLY BOLLING

R. E. DALTON ENGR
 GREENVILLE S. C.

Recorded Jan. 27, 1920 by R.E.D.

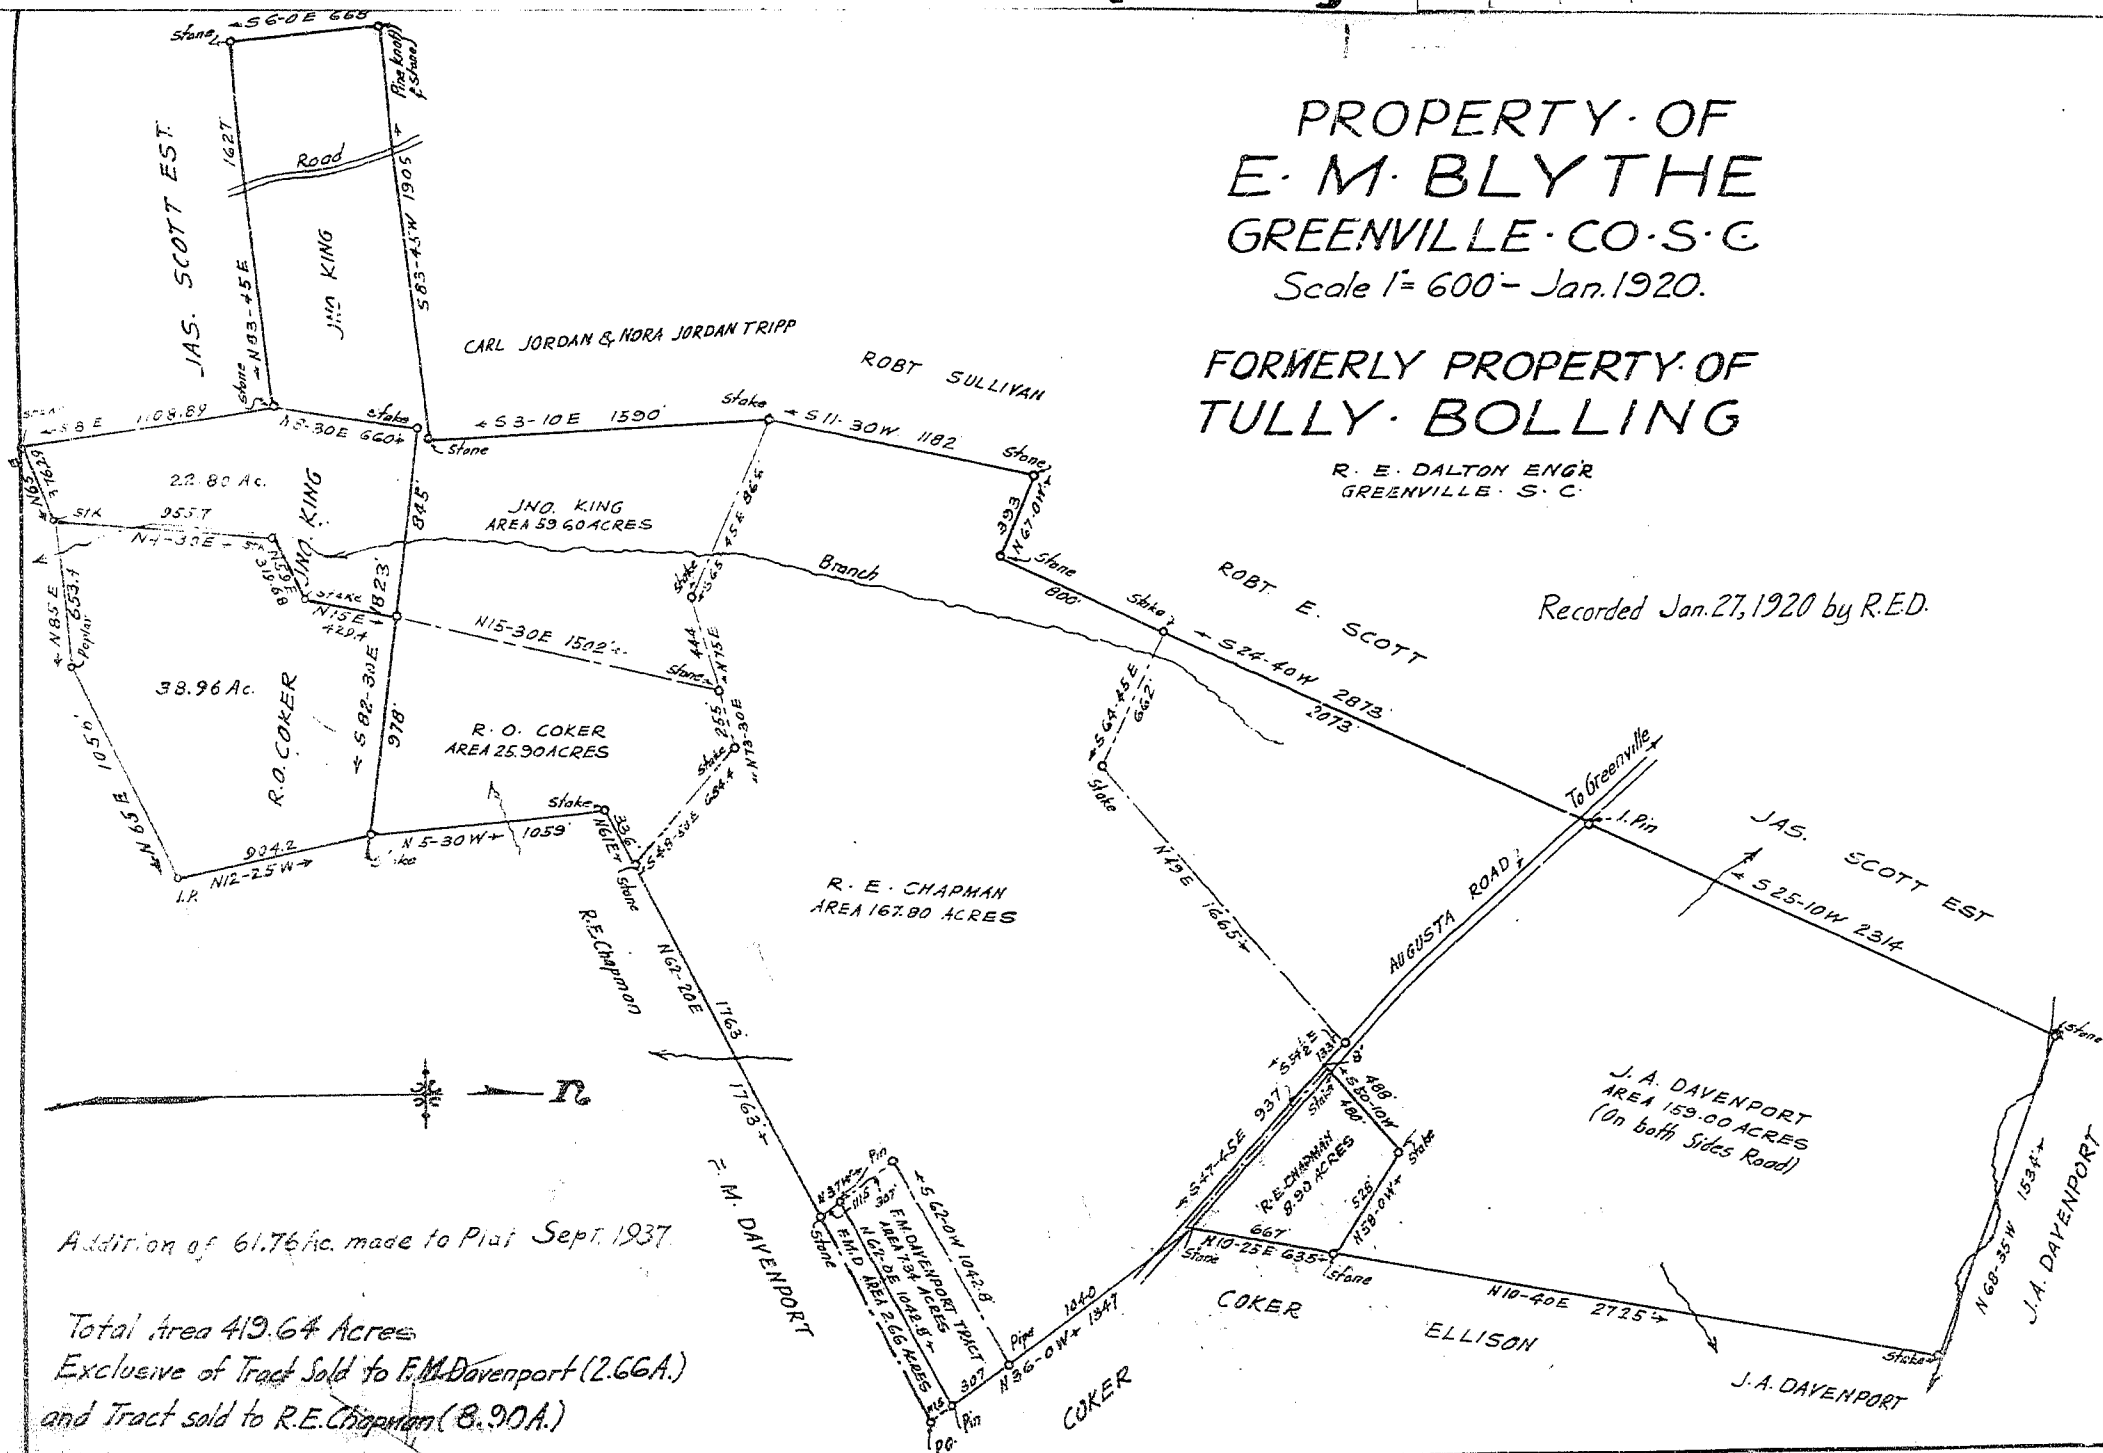

Addition of 61.76 ac. made to Plat Sept. 1937

Total Area 419.64 Acres
 Exclusive of Tract Sold to F.M. Davenport (2.66 A.)
 and Tract sold to R.E. Chapman (8.90 A.)