


MOUNTAINVIEW AVENUE

S. 80-15 E →


50'

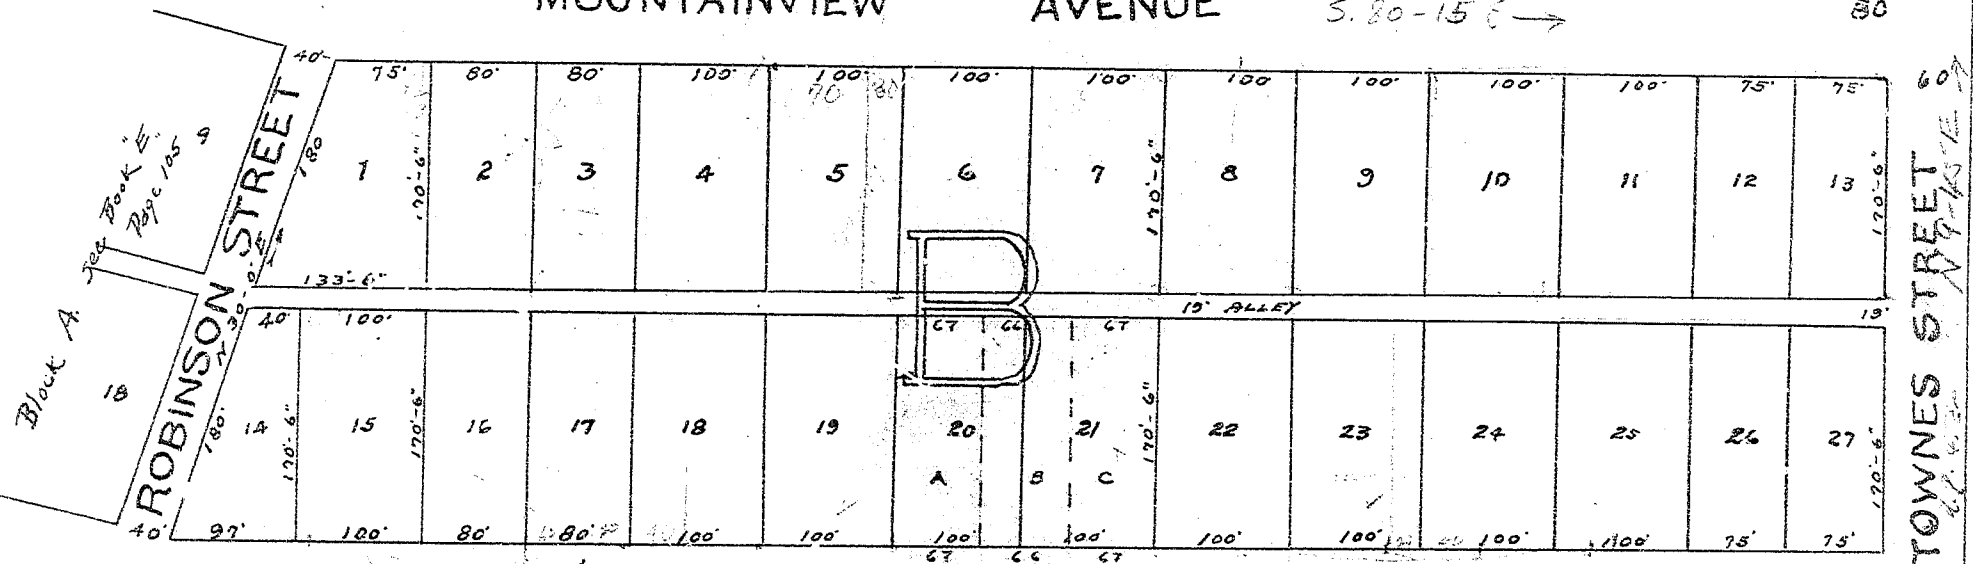

BUIST AVENUE

← N. 80-15 W.

80'

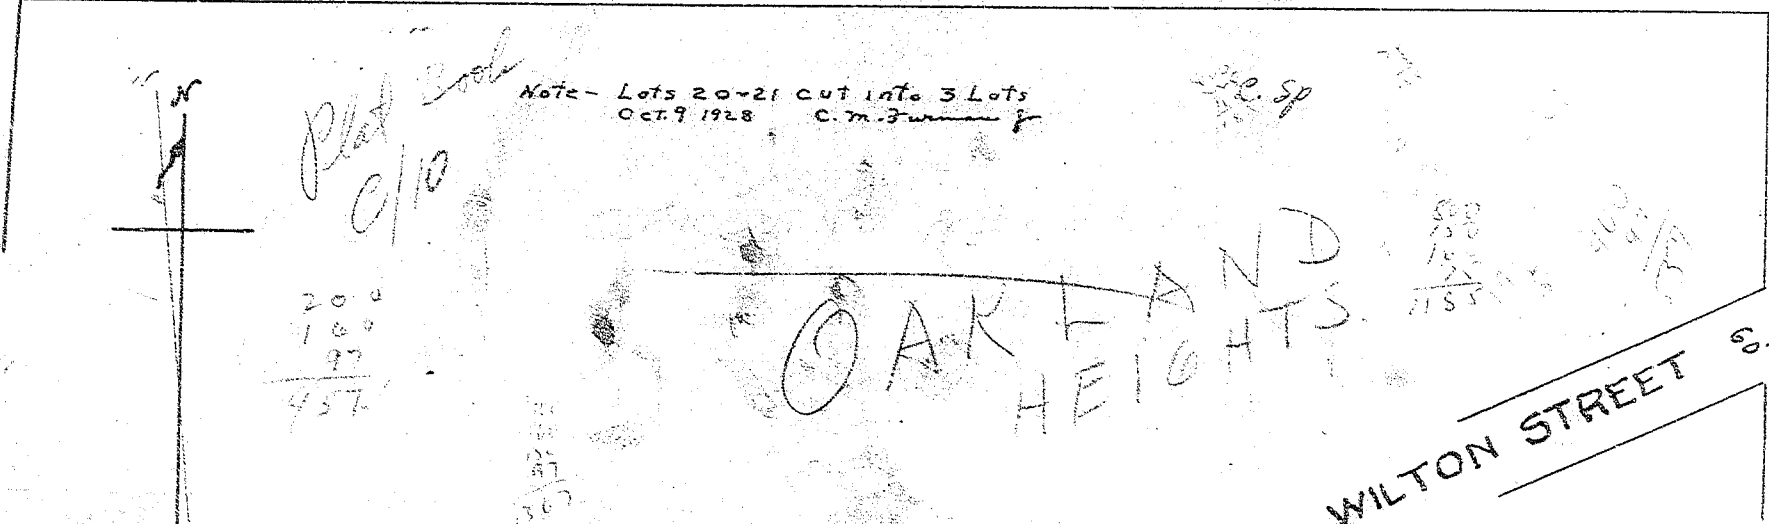

MAPPED BY W.D. NEVINS Greenville S.C. June 15E 1911

Recorded Map 28 1924 W.D.N.

BAD COPY