

553.6
148.0

215.6

91.1
95.2



186.3

MAP OF
ALTA VISTA
 PROPERTY OF
R.B.R. LAND DEVELOPMENT CO.
 IN AND ADJOINING
GREENVILLE S.C.

SCALE OF FEET
 0 100 200 300 400

JUNE 1825

R.B. DALTON

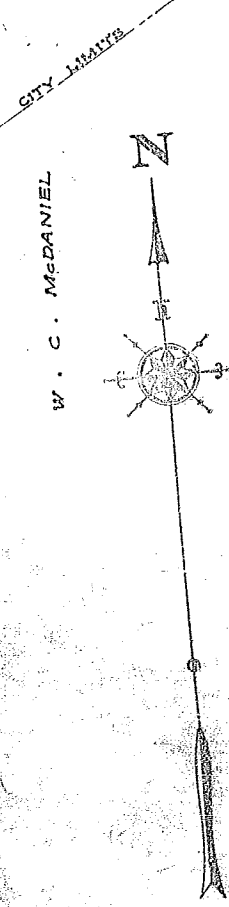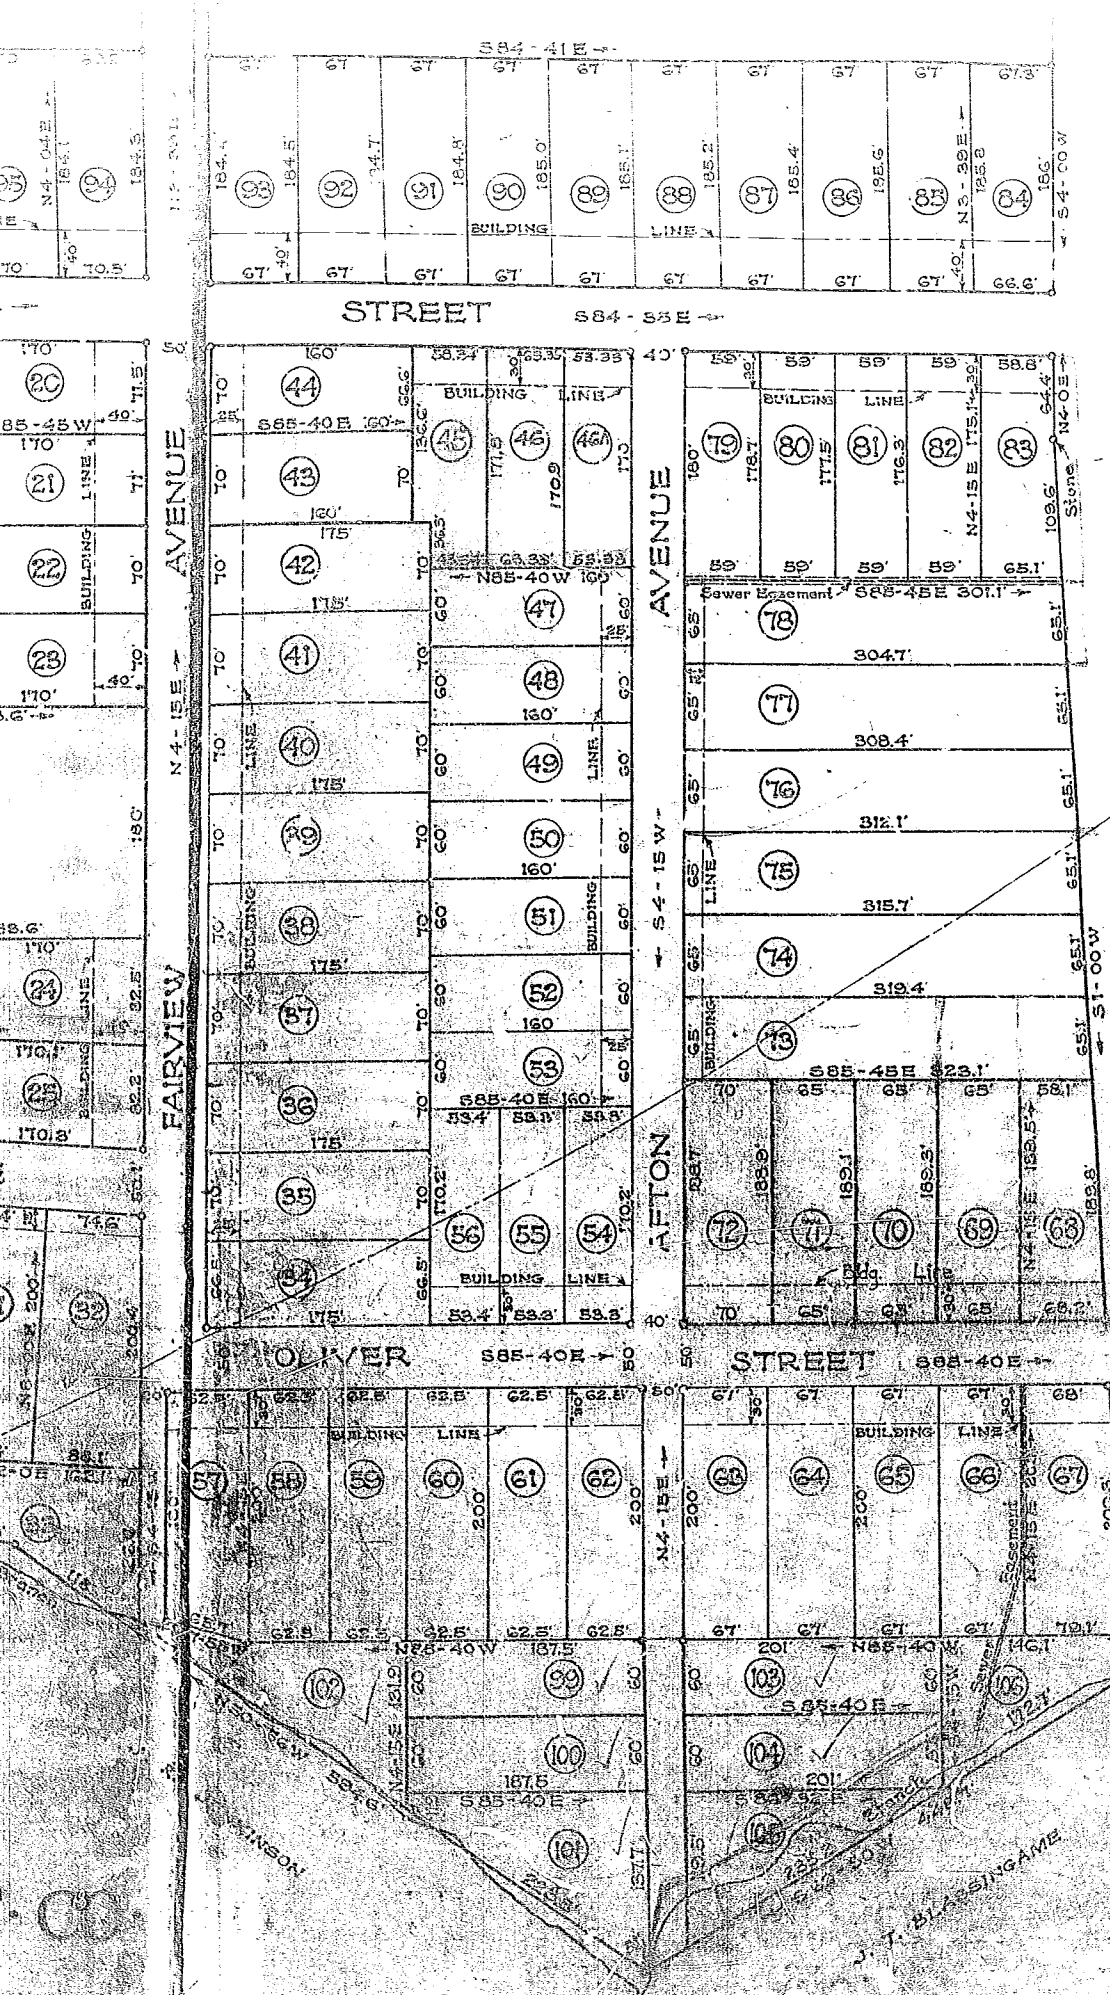

Revision Lots 43-46 made July, 1930. Revision Lots 68-72 made June, 1931.
 Iron Pipe at all Corners not otherwise noted.
 Revision of Plat made Nov. 1925.
 Revision of Lots 2 to 6A made Oct. 1926. Lots 78, 104 made April, 1927.