


AMENDMENT OF PLAT OF WHARTON PROPERTY.  
SEE PL. Bk. F. 87 McH. 1922-1<sup>st</sup> 20<sup>th</sup> Aug. 1934

- ⊙ Single Circle Shows Lot Nos. Recorded Pl. 3<sup>rd</sup> F. 27
- ⊖ Double " " " " City Block Bk. Sheet 2-B1.3

RICHARDSON ST.

W. COFFEE ST.

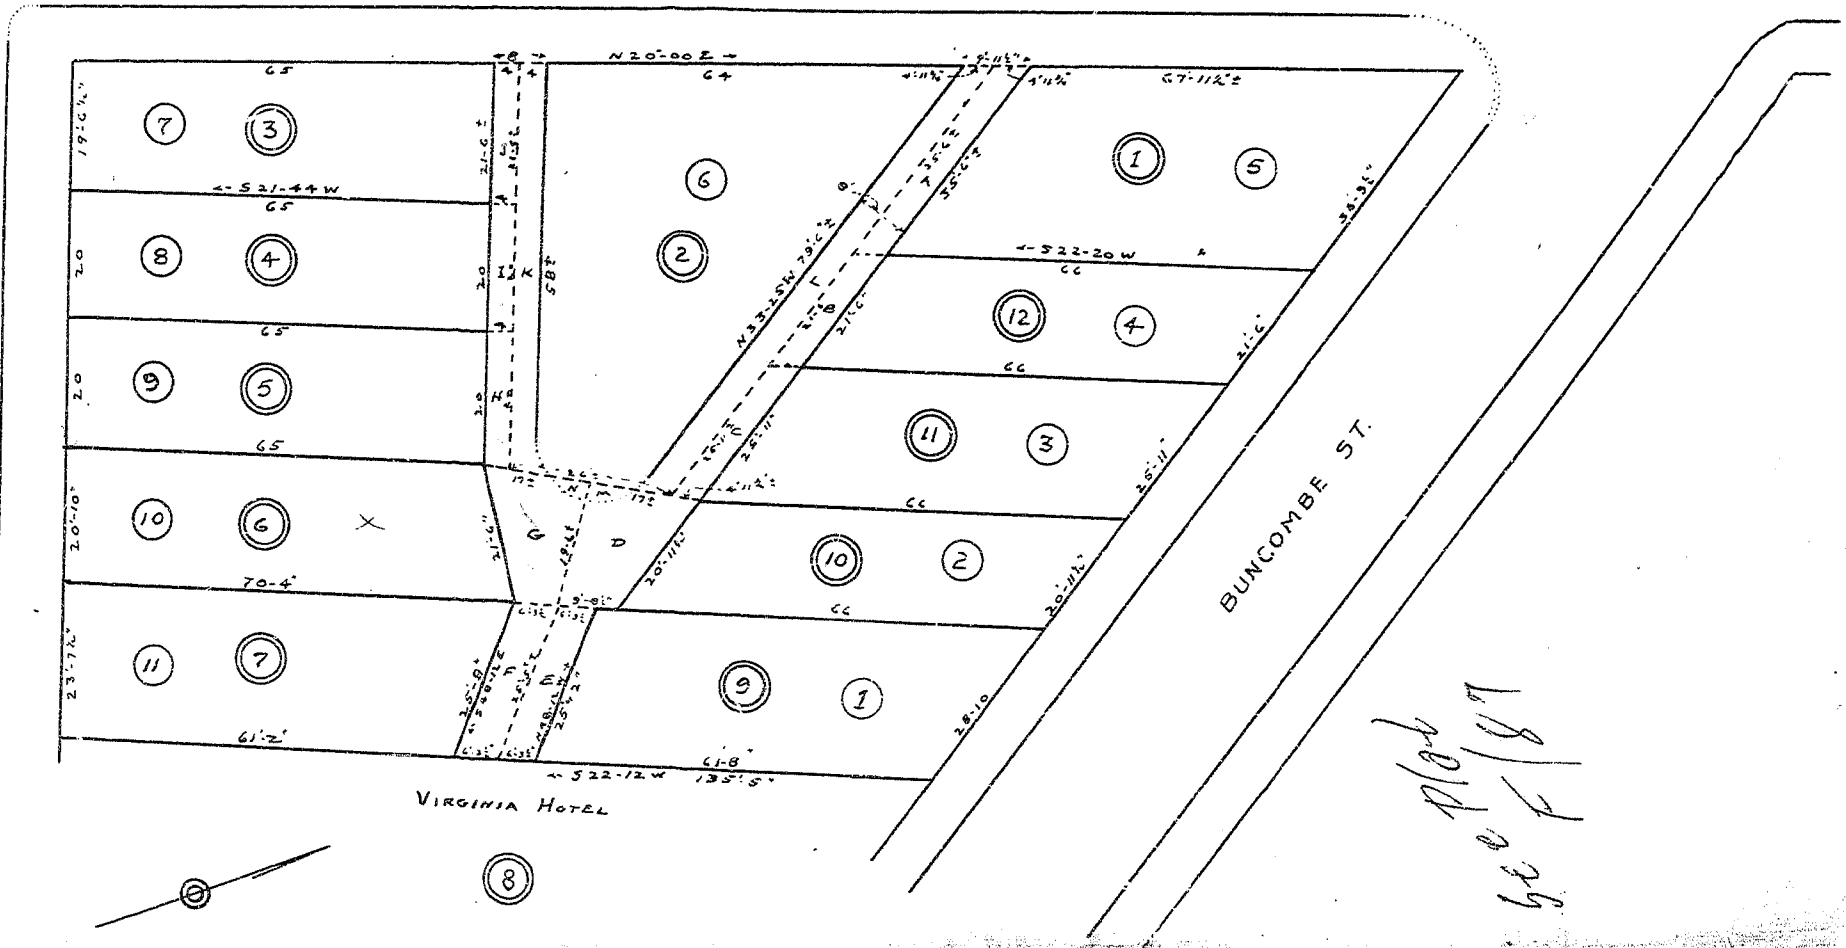

250