


30

Received
...

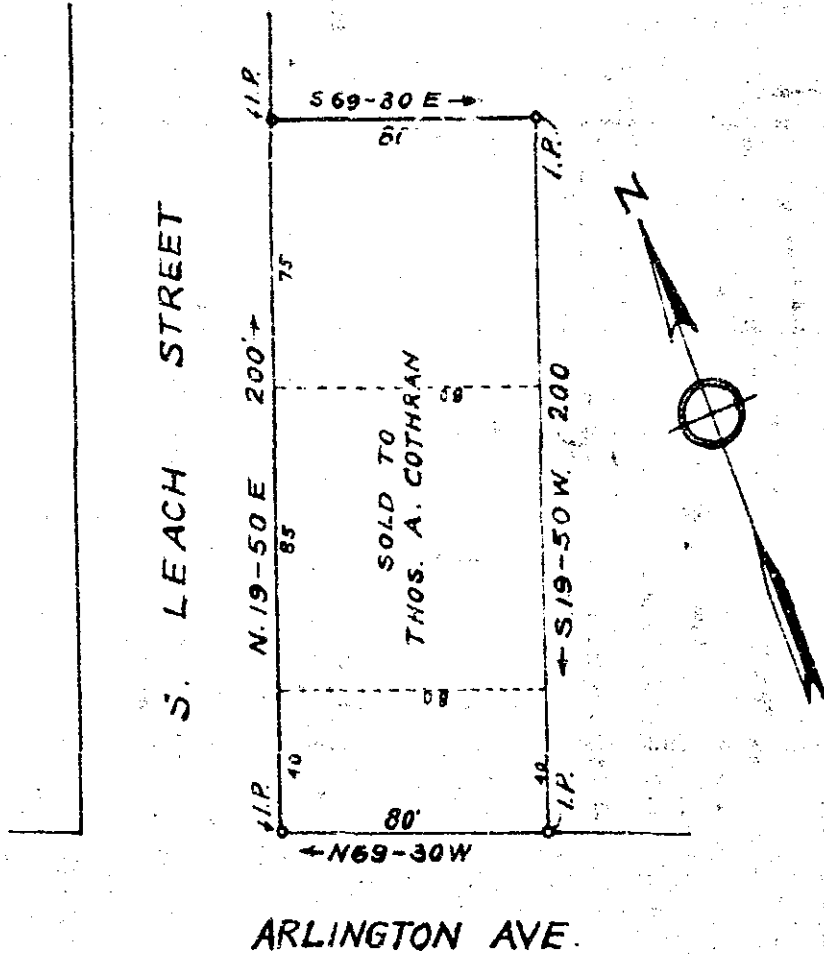

ESTATE OF
MRS. ELIZA K. MAULDIN

ARLINGTON AVE. & LEACH ST.

GREENVILLE · S · C

Scale 1"=50' June 1935

DALTON & NEVES

F. Book No 150.

1935
FEB 10 1937

Dotted Lines & small figures added to original