


# Plat Book I, Page 61B

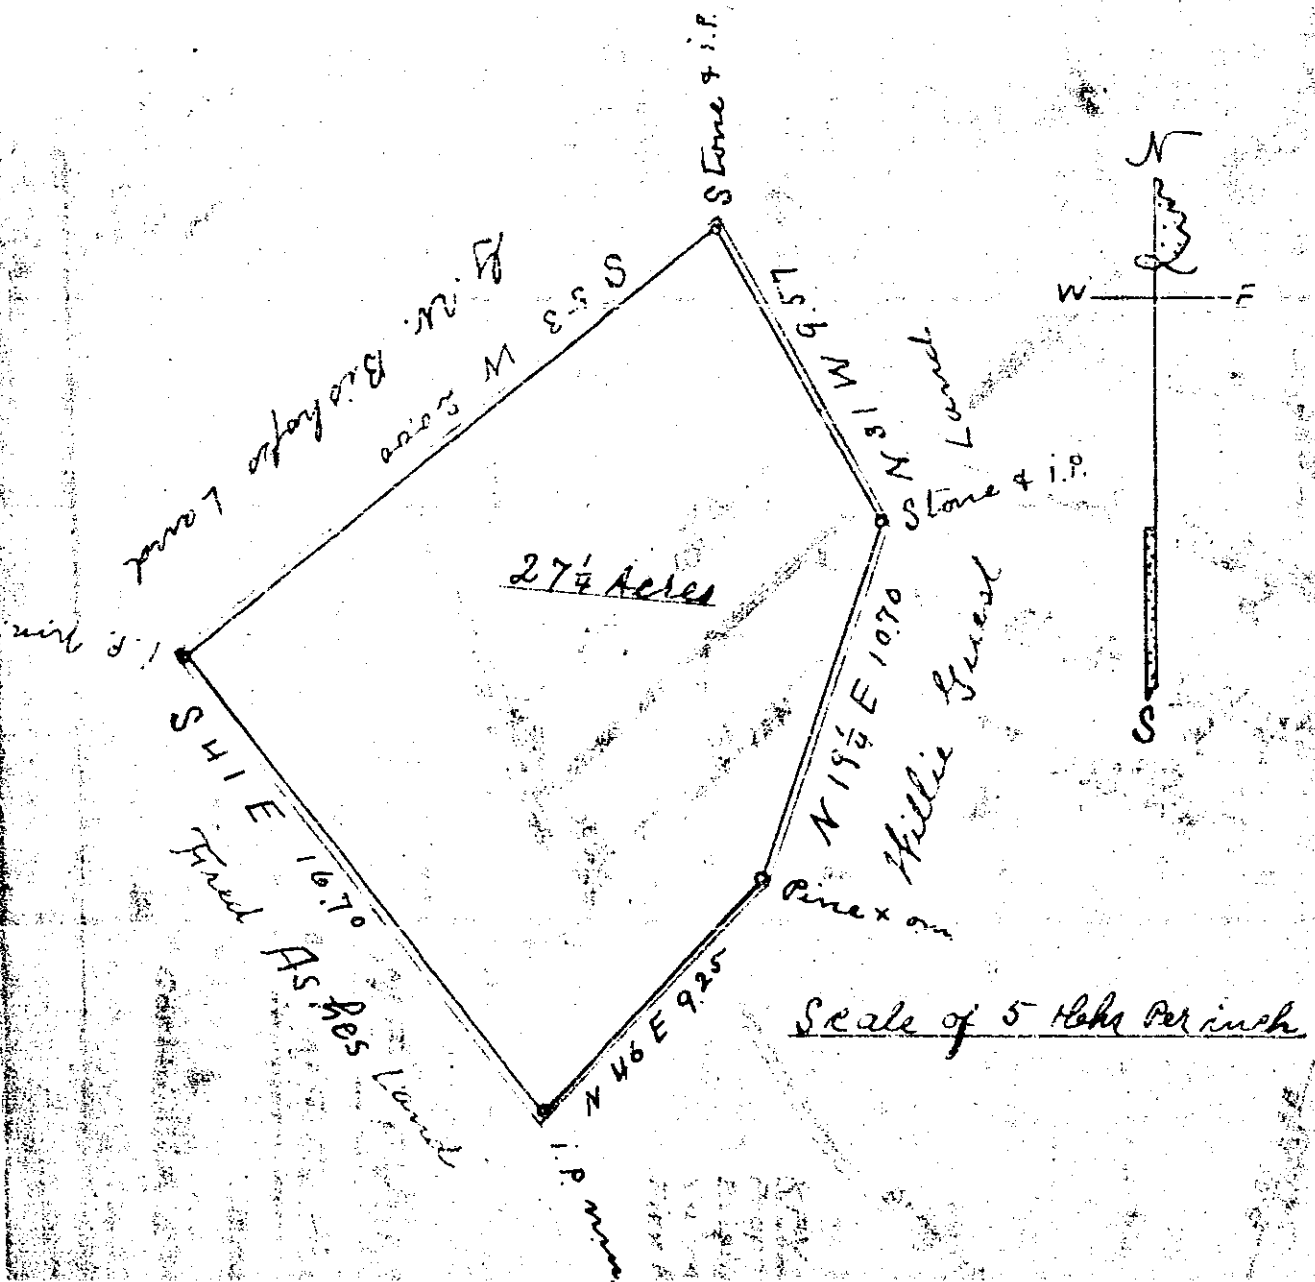

South Carolina  
Greenville County

I have surveyed and divided a certain tract of land for J. A. Gates and Fred Ashe, and find the above tract to contain 27 <sup>1</sup>/<sub>4</sub> Acres. Surveyed May 2 1936

H. A. Hester L.S.