Plat Book-K-Page 113A

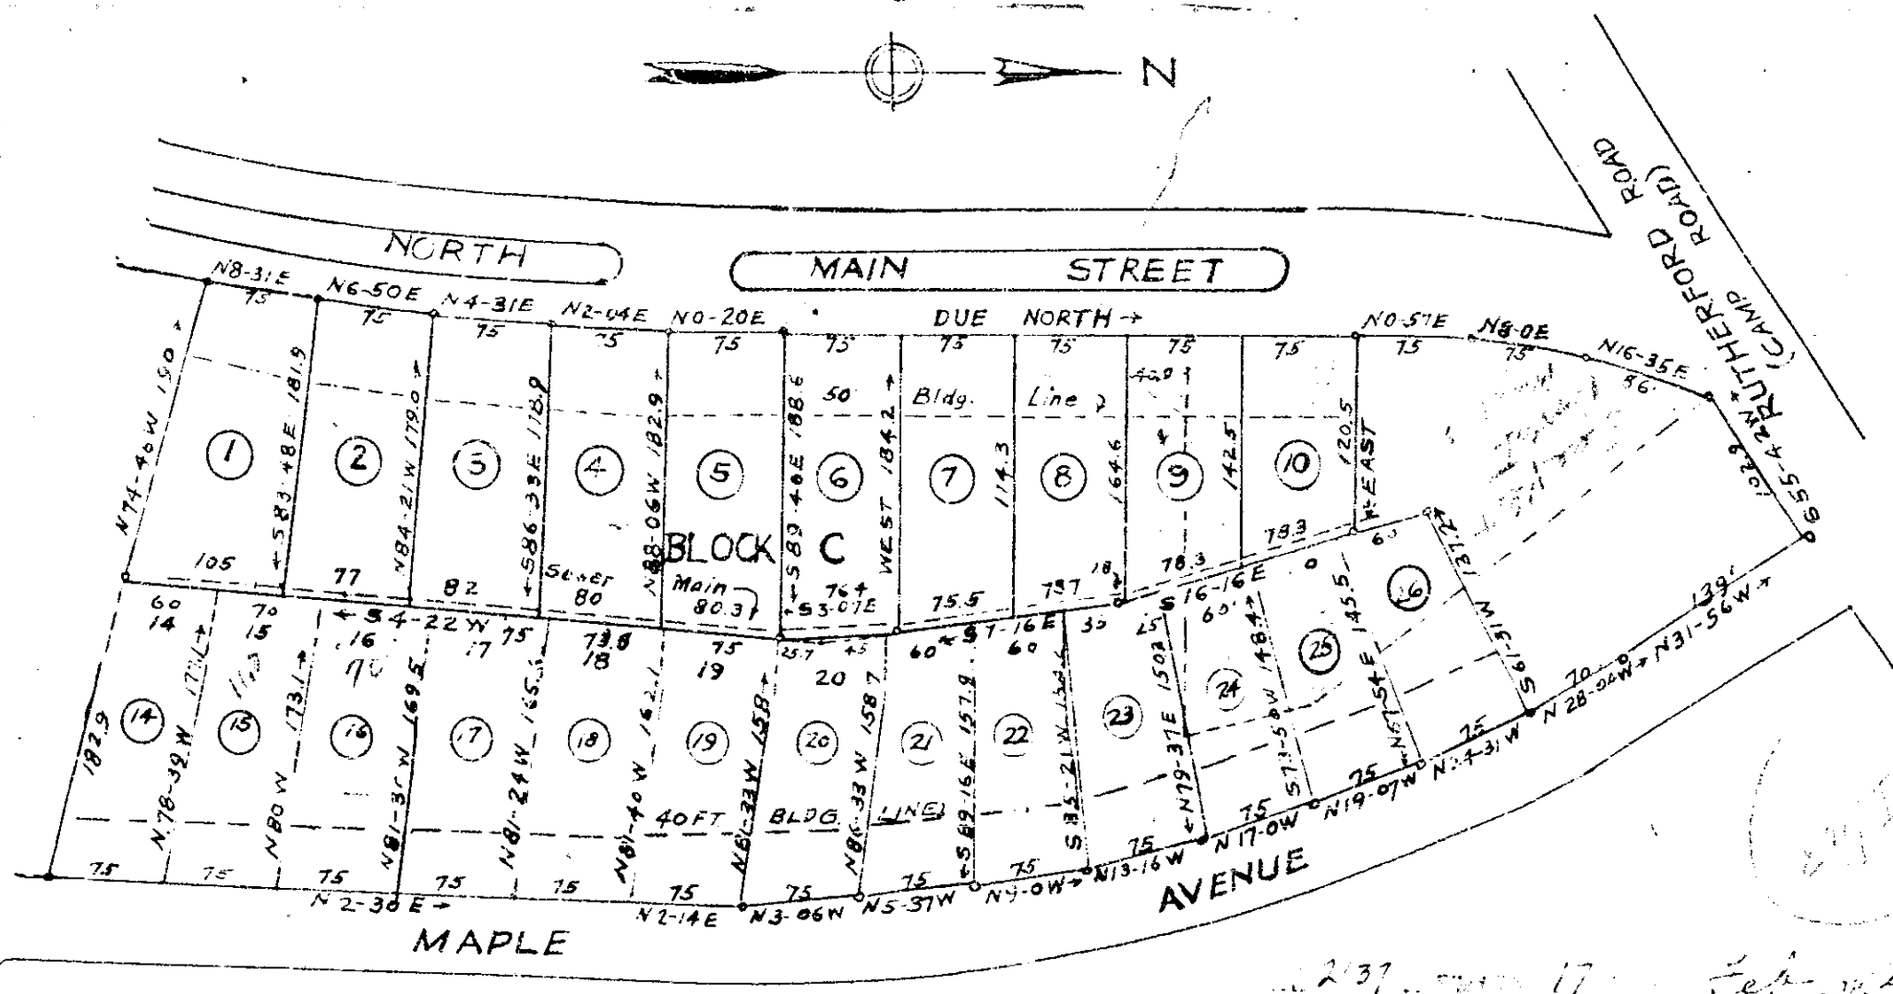

2/37 17 Feb 1942
113
Alice Flowers
Register Deeds Conveyance Greenville County, S.C.

NORTHGATE
PROPERTY OF
J. A. & P. F. CURETON
NEAR GREENVILLE S.C.
Scale 1"=100' Feb. 1942
REVISION OF PART BLK. C

F. Book 200 DALTON & NEVES
-218.

Iron Pins at all Corners
Addition to Plat made Feb. 1944
Lots 14-20 Inc. Subdivided by W.N. Neves

Iron Pins at all Corners