


NORTHGATE

PROPERTY OF
UTOPIAN DEVELOPING CO.
GREENVILLE S.C.

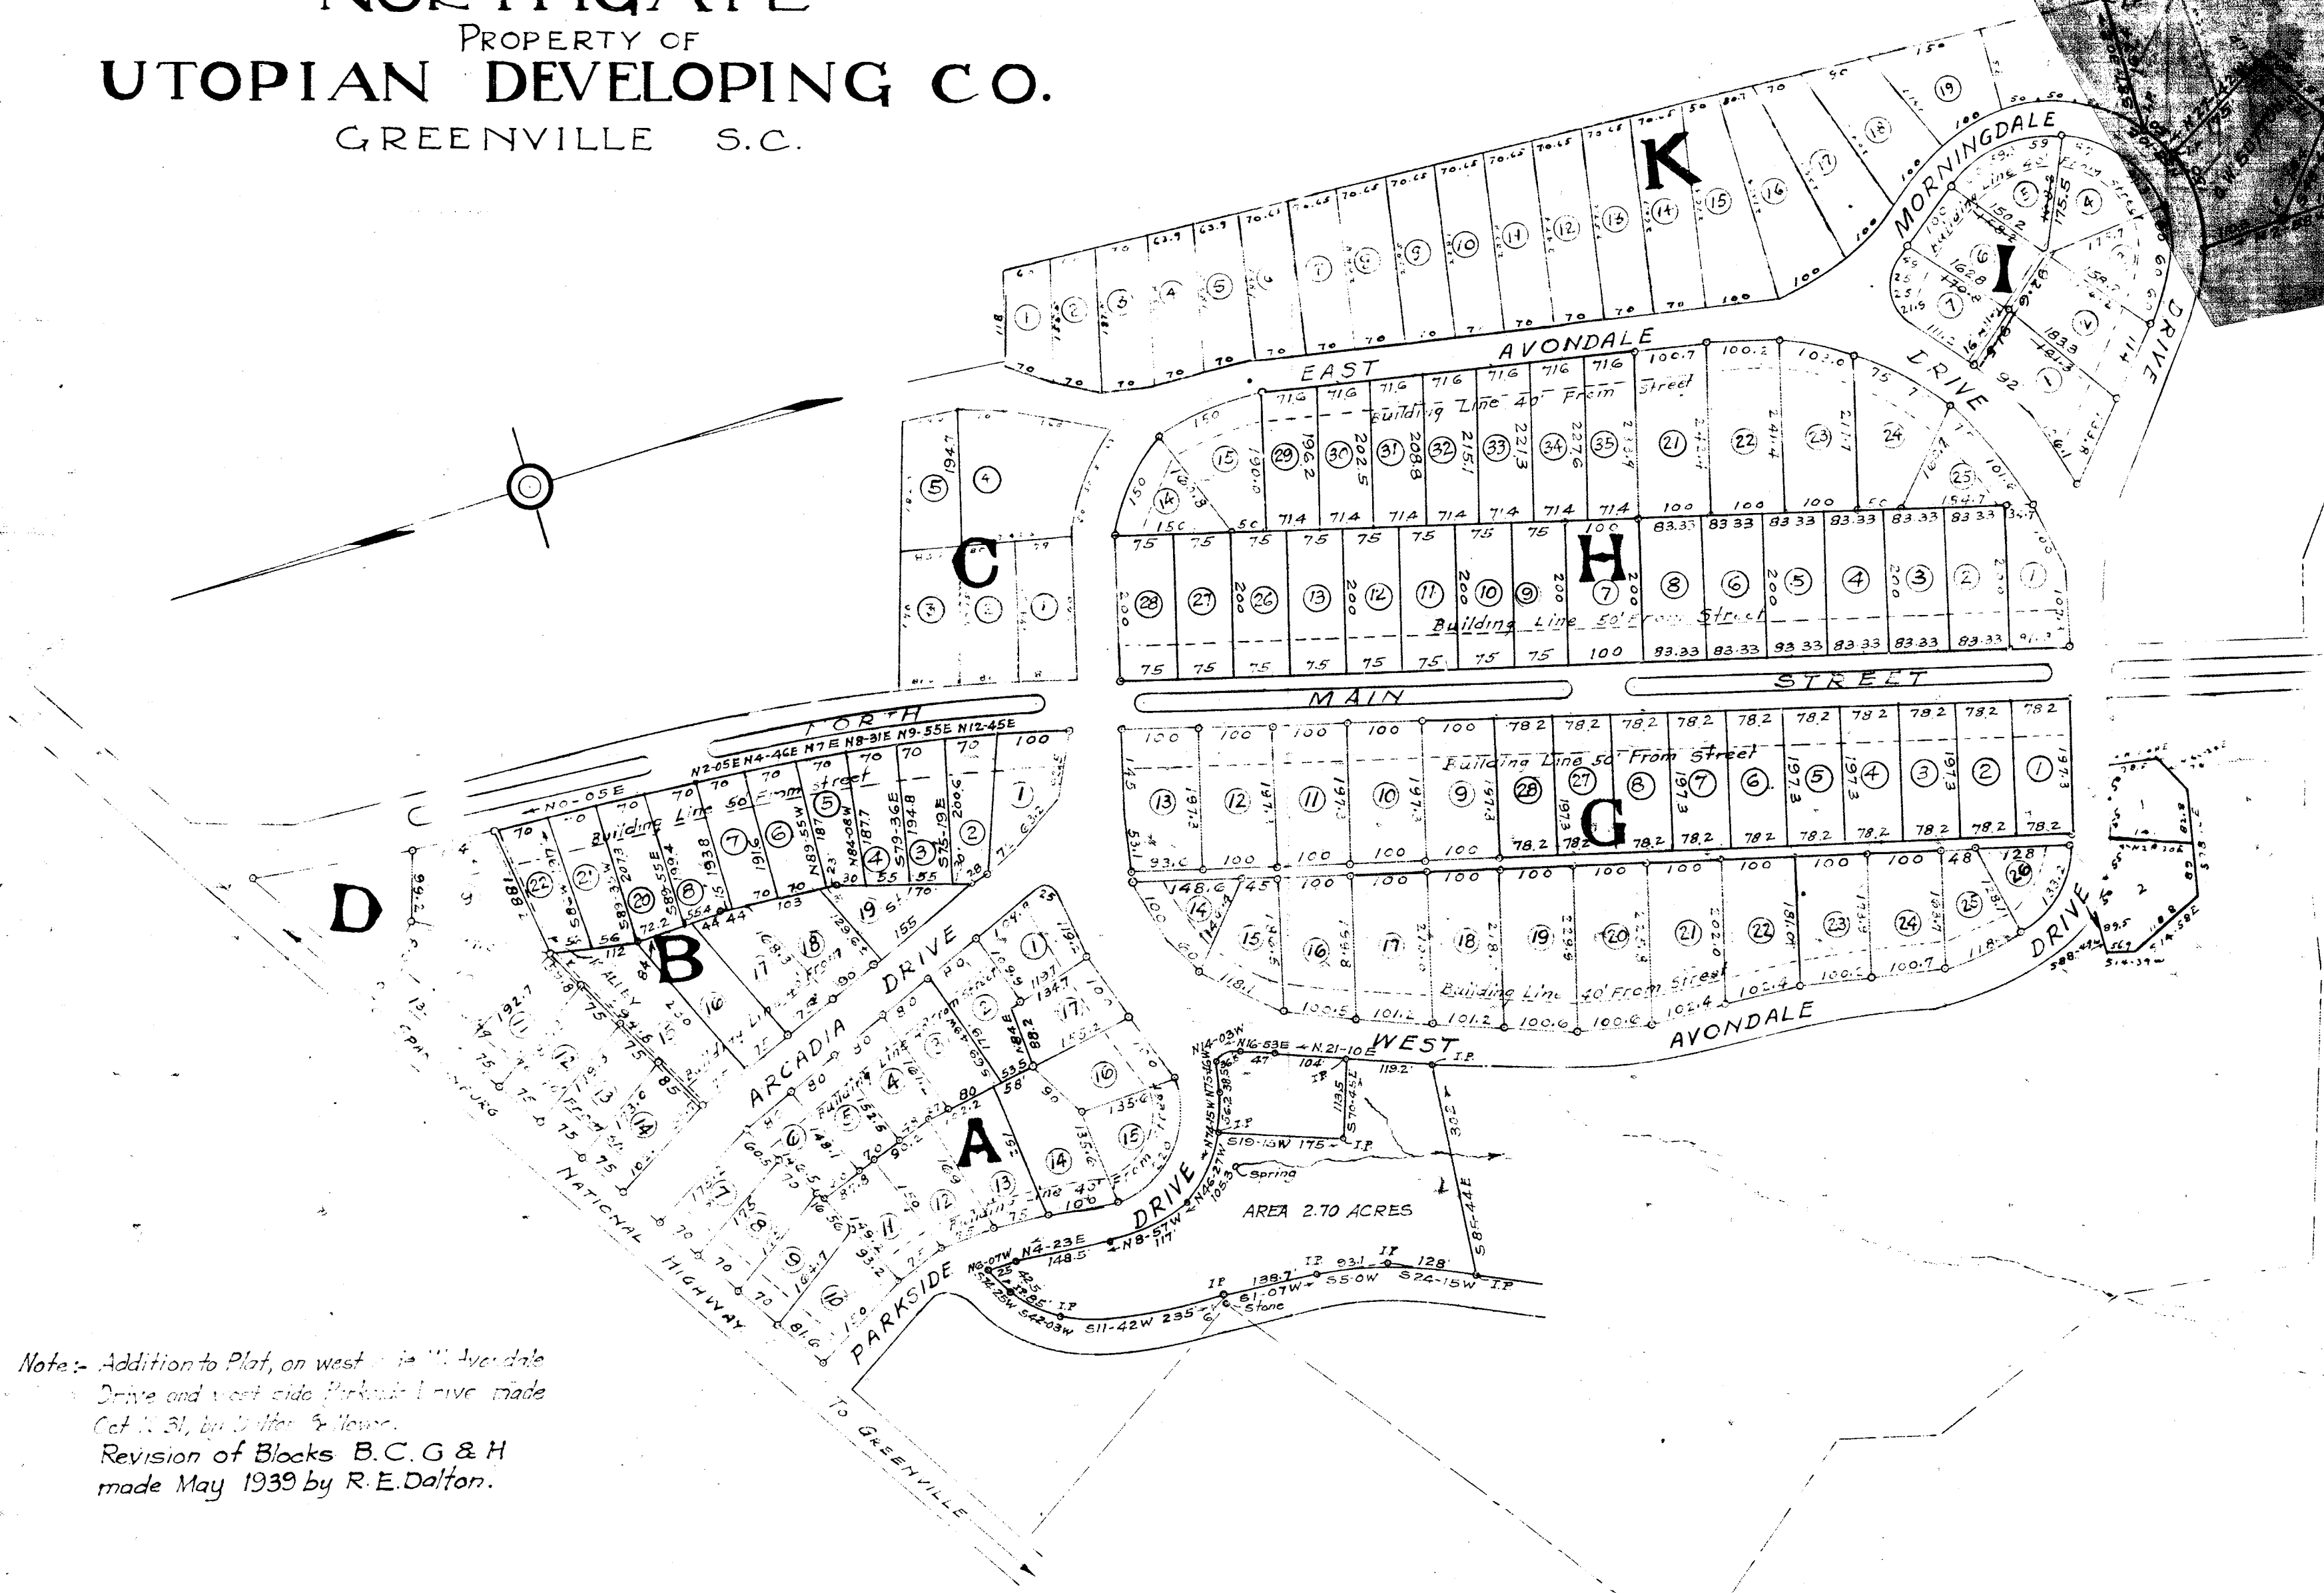

Note: - Addition to Plat, on west side of Avondale Drive and west side Parkside Drive made Oct. 31, by D. H. & H. W. R. Revision of Blocks B, C, G & H made May 1939 by R. E. Dalton.

NOTE - ABOVE REVISED FROM PLAT MADE BY G. A. SCHULTZE LOTS ONLY. RESURVEYED STREETS AND OUTSIDE PROPERTY LINES TRACED SURVEYED AND TRACED BY W. M. RAST

RECORDED IN PLAT BOOK "G" 135-136 R.M.C. OFFICE

EASEMENT OF 2 FT. ON REAR OF EACH LOT (SEWER - GAS - ELECTRIC LIGHT POLES ETC)
C. M. FURMAN JR. JUNE 1926