
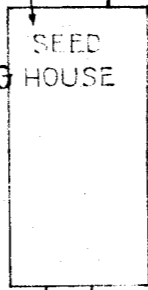


GREENVILLE COUNTY, S. C.
VAL. SECT. 44 SHEET 27
PARCEL NO. 3

WAREHOUSE 1789.0 SQ. FT.
LOT 39107.0 SQ. FT.
TOTAL AREA 40896.0 SQ. FT.

PIEDMONT MANUFACTURING
CO. FRAME WAREHOUSE

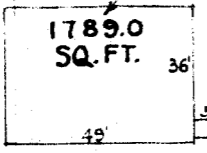

OVERHEAD SEED CONVEYOR

OFFICE
SCALES

GREENVILLE COTTON OIL MILL, INC. (A.P.)

COAL YARD

GREENVILLE COTTON OIL MILL, INC.
(A.P.)

FENCE

SOUTHERN RAILWAY SYSTEM
EASTERN LINES


PIEDMONT, S. C.

WATER PIPE CROSSING & ENCROACHMENTS OF
PIEDMONT MANUFACTURING CO.



SCALES AS SHOWN

JUNE 23, 1943
REVISED JULY 20, 1943
REVISED AUG. 5, 1943

OFFICE OF CHIEF ENGINEER M. W. & S. E. L. CHARLOTTE, N. C.

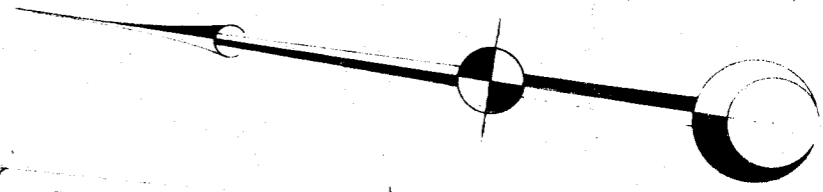

No. 3

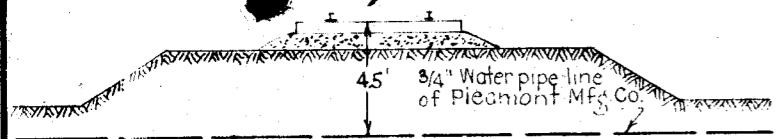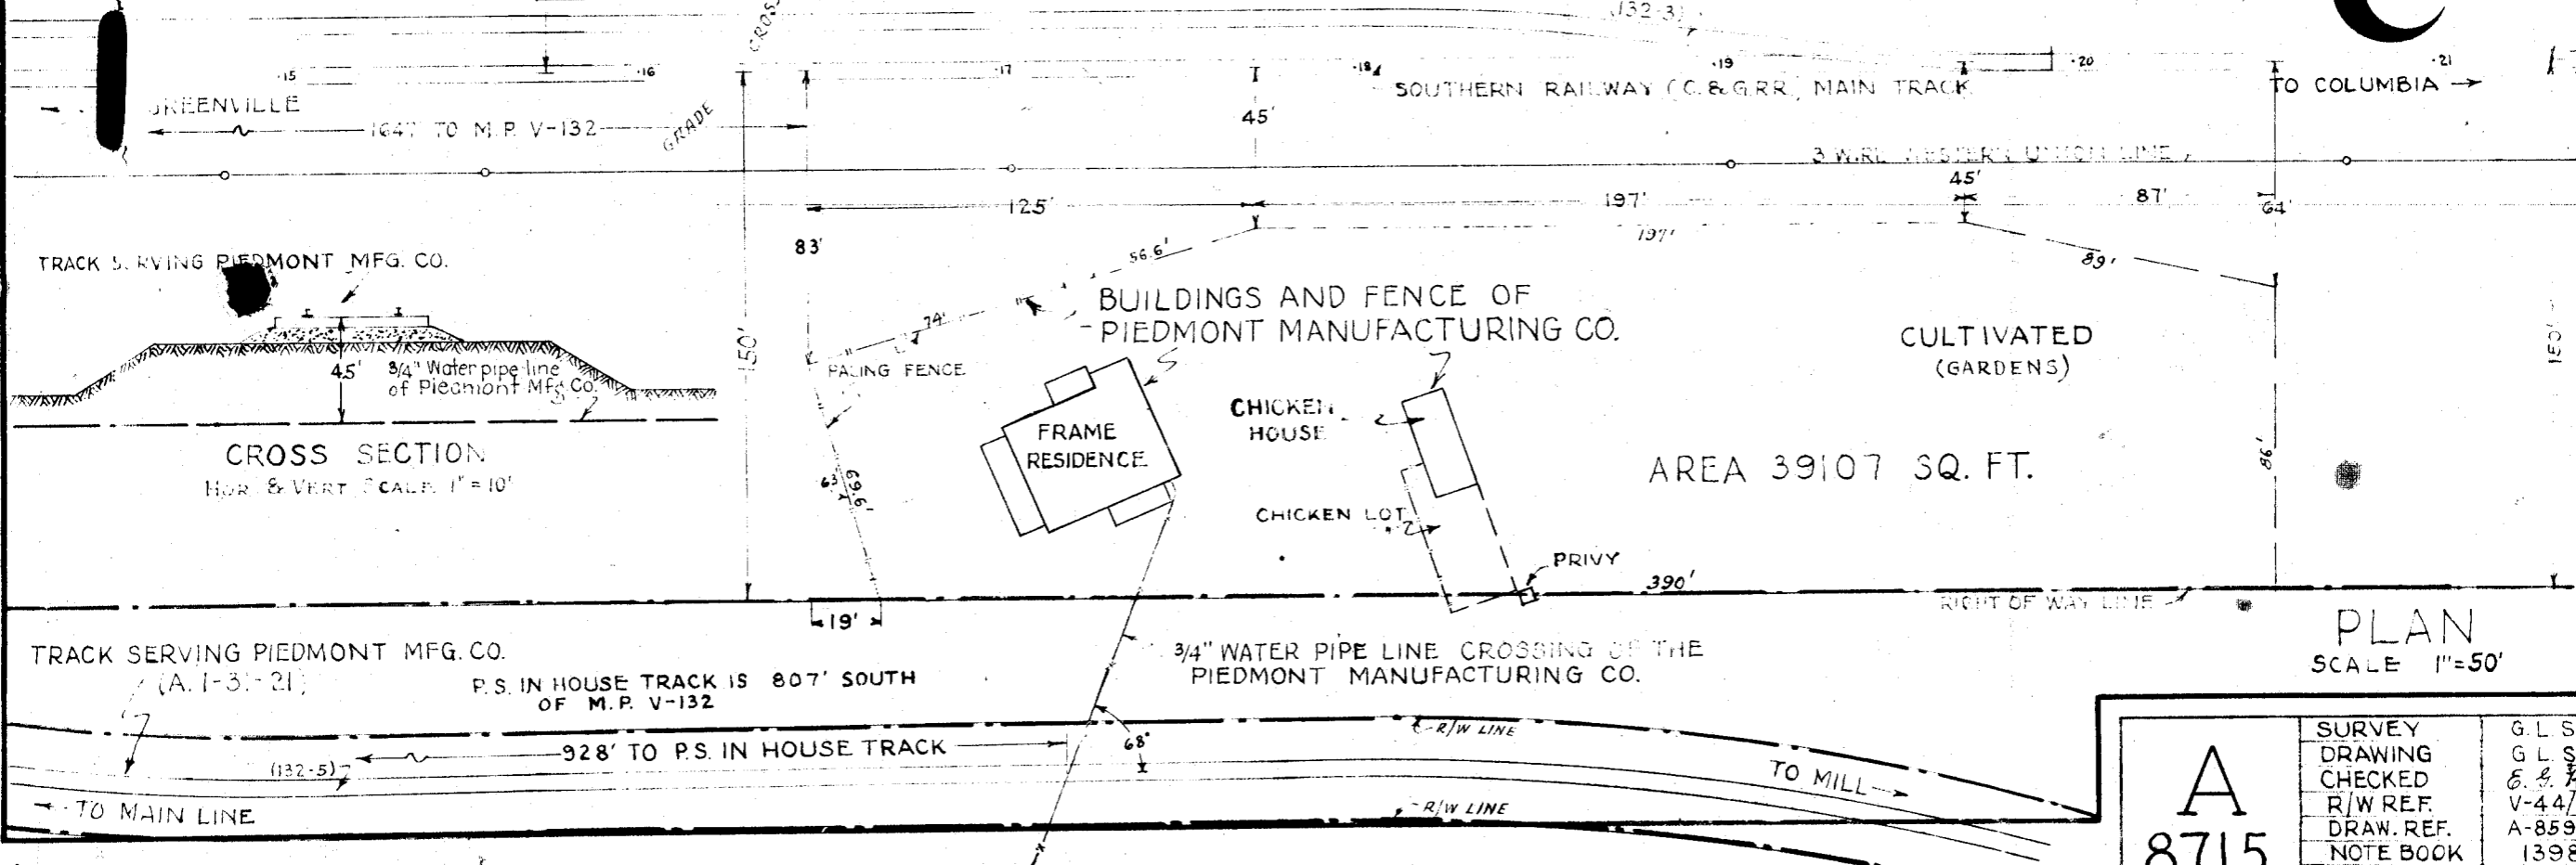

CROSS SECTION
HOR. & VERT. SCALE 1"=10'

AREA 39107 SQ. FT.

PLAN
SCALE 1"=50'

A 8715	SURVEY	G. L. S. Jr.
	DRAWING	G. L. S. Jr.
	CHECKED	<i>E. S. K.</i>
	R/W REF.	V-44/27
	DRAW. REF.	A-8599
NOTE BOOK		1398
FILE NO.		M-7033