


NEW BUNCONBE ROAD

← TO ASHVILLE

TO GREENVILLE →

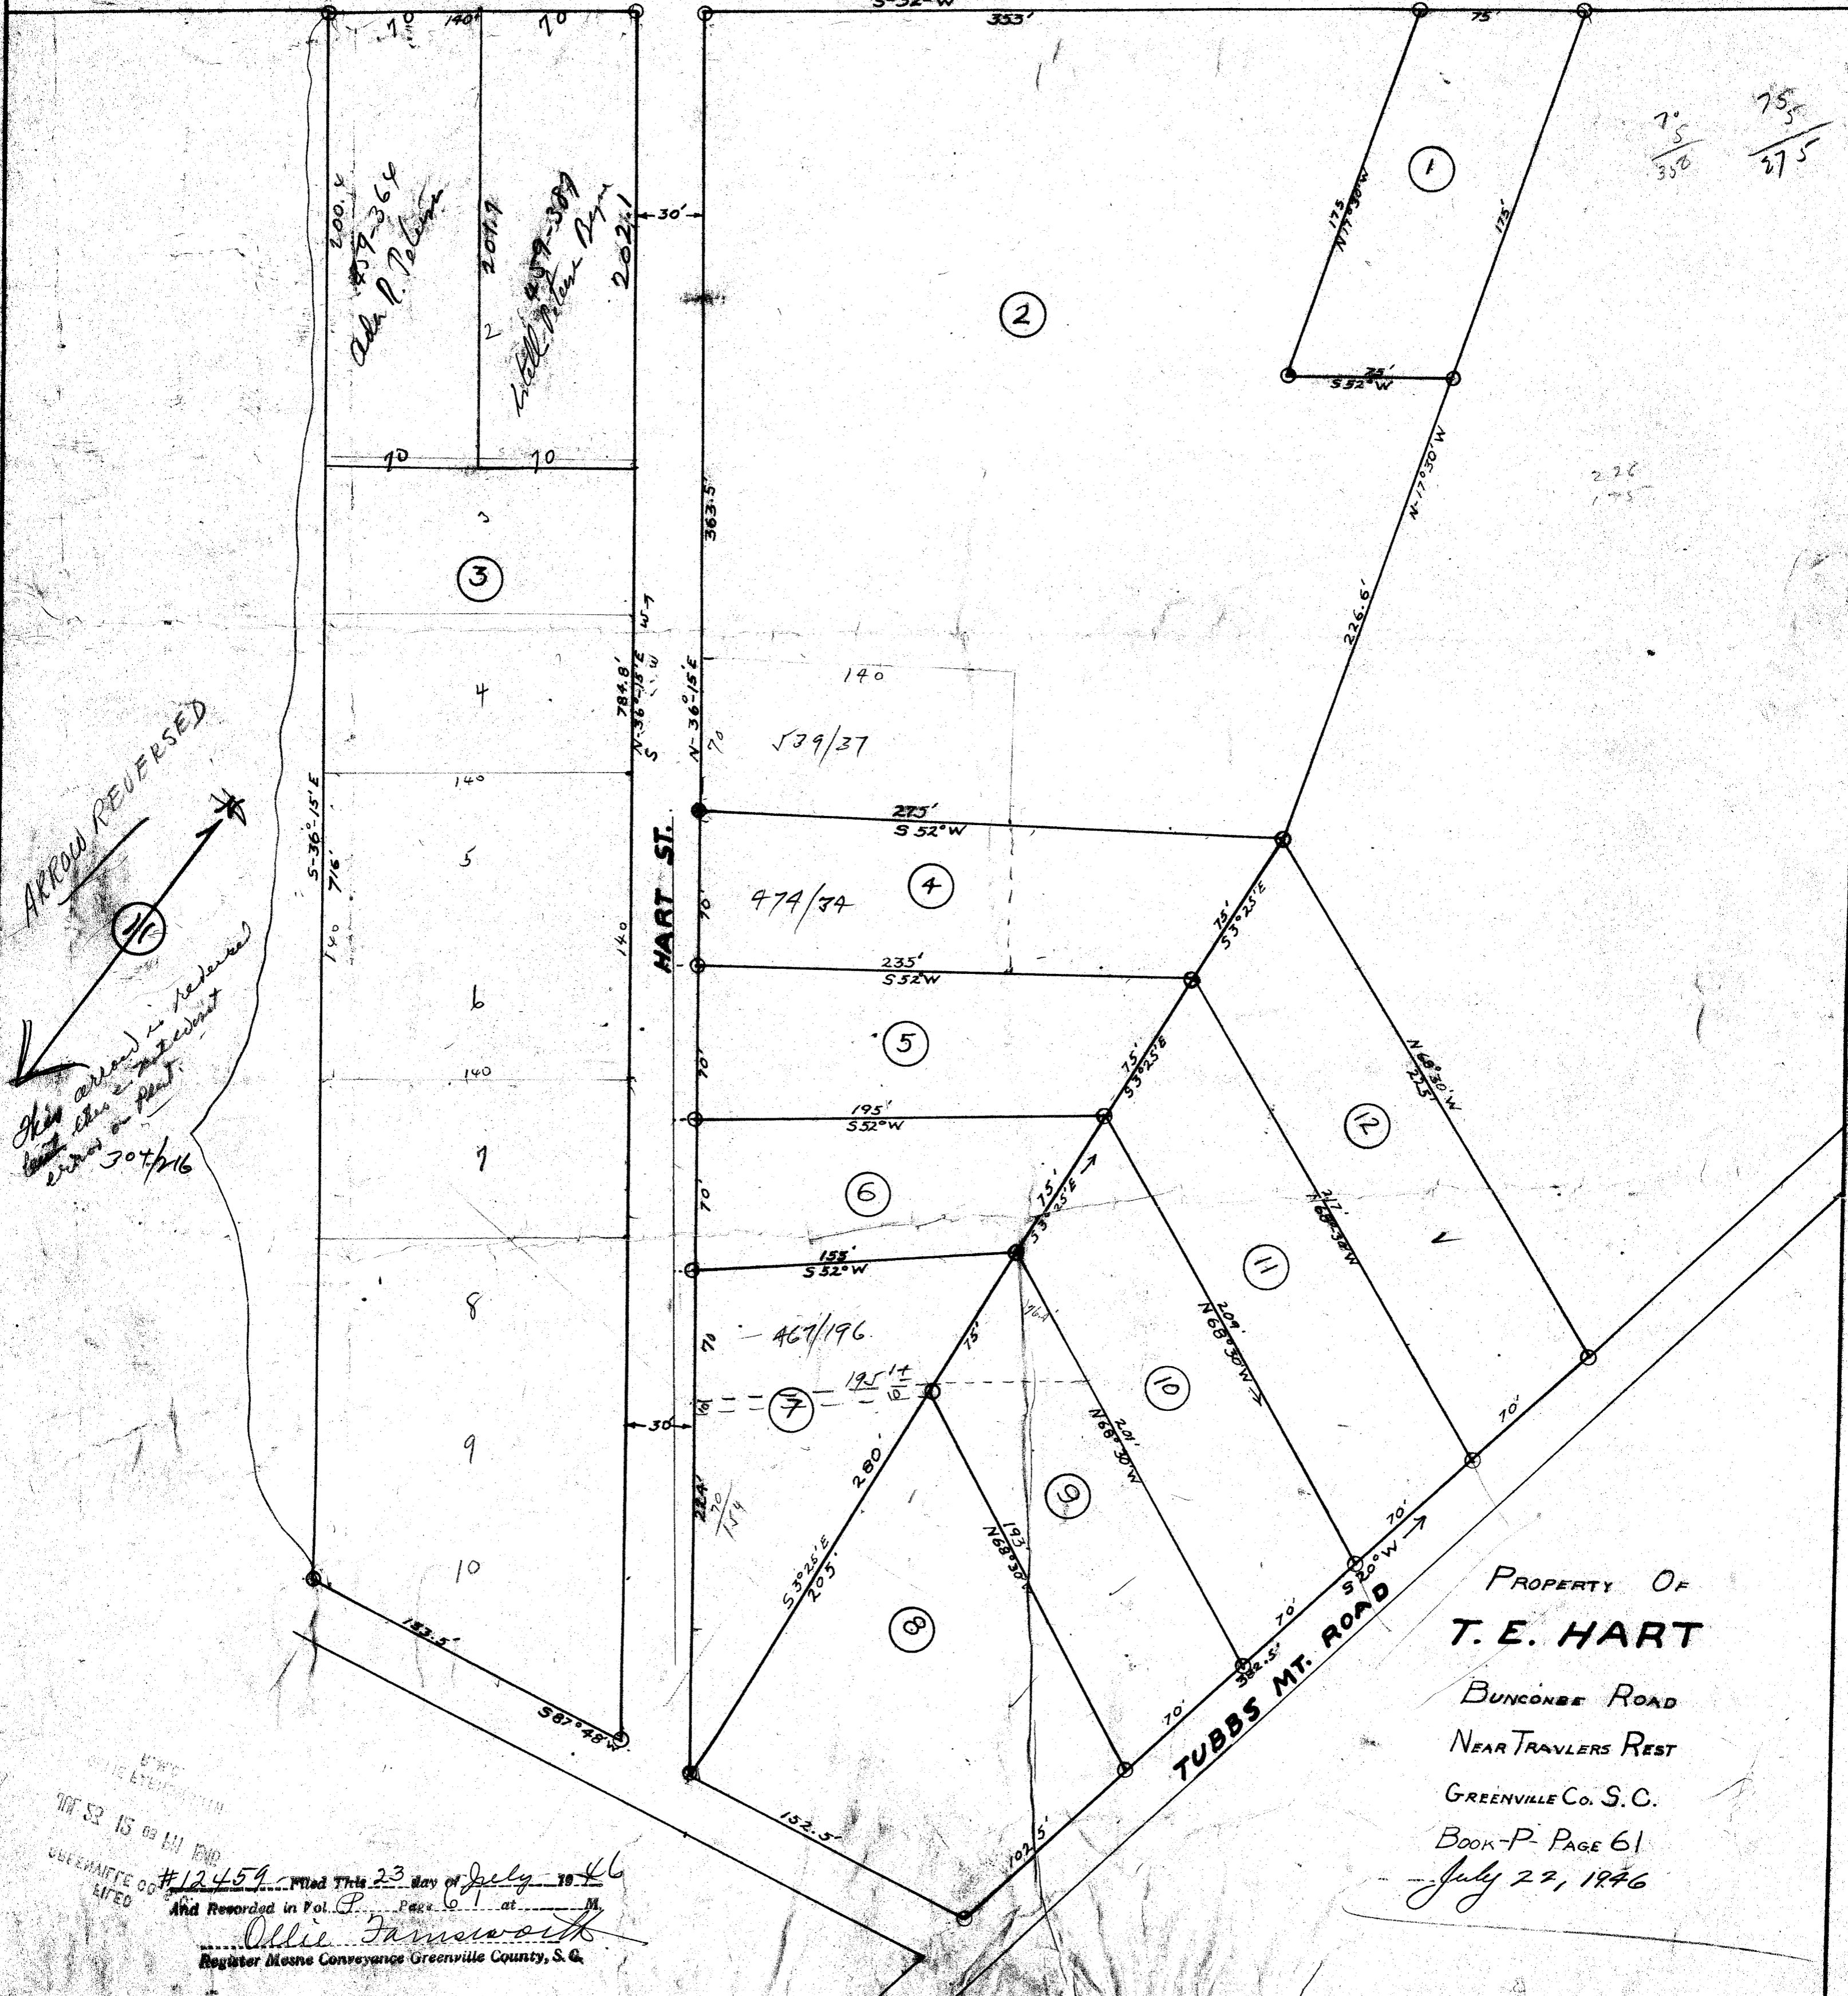

PROPERTY OF
T. E. HART
 BUNCONBE ROAD
 NEAR TRAVLERS REST
 GREENVILLE CO. S. C.
 BOOK-P PAGE 61
 July 22, 1946

#12459 Filed This 23 day of July 1946
 And Recorded in Vol. P Page 61 at M.
 Ollie Farnsworth
 Register Meane Conveyance Greenville County, S. C.