


151
JUN 28

P-144
PROPERTY OF
J. C. MILFORD
GREENVILLE CO. S.C.
Scale 1"=200 May 1923

R. E. DALTON ENGR.

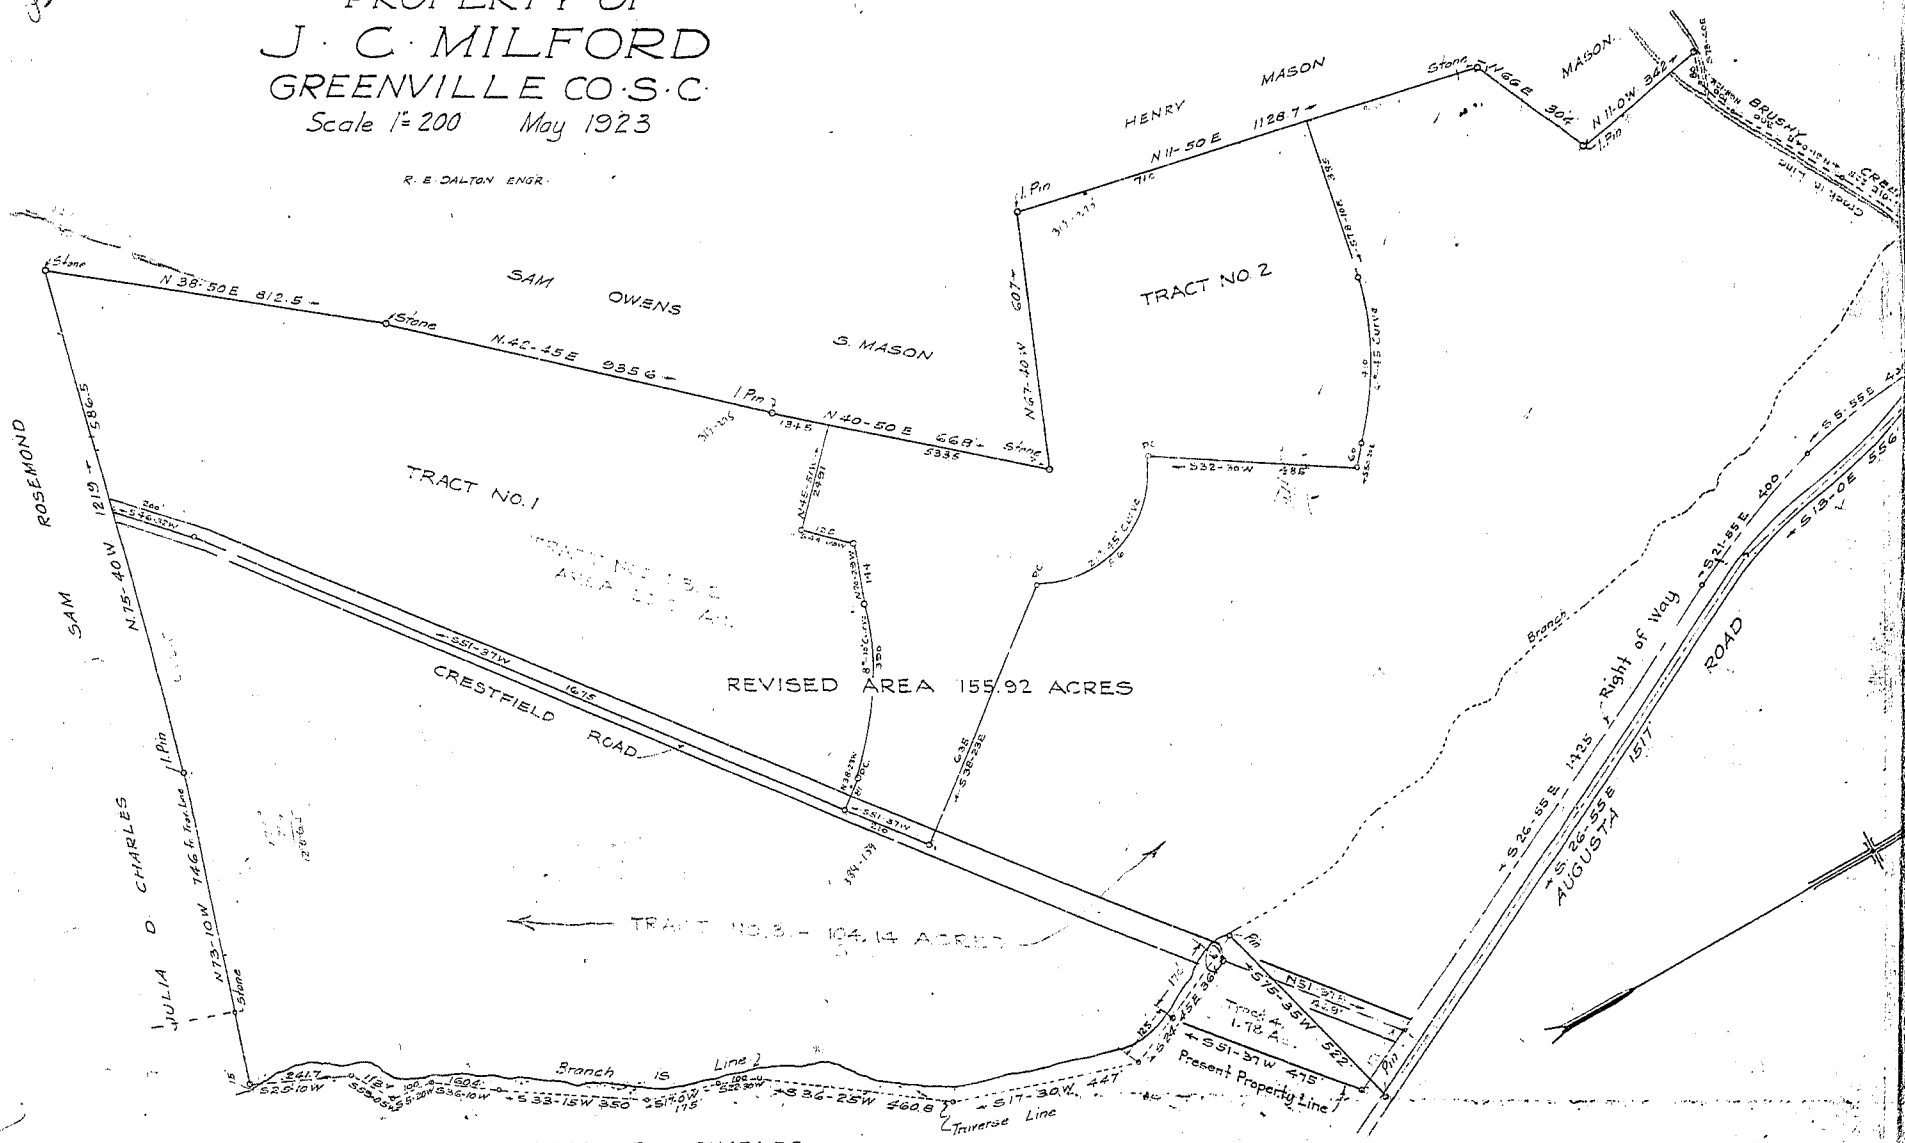

TRACT NO. 3 - 104.14 ACRES

JULIA D. CHARLES

Revision of Plat made May 1949

Field Book No. 72
JOB NO. 975-1

BAD COPY