


Robert Thompson

Litt, Balsam and Child

JAN 3 1947
 Accepted
 1947

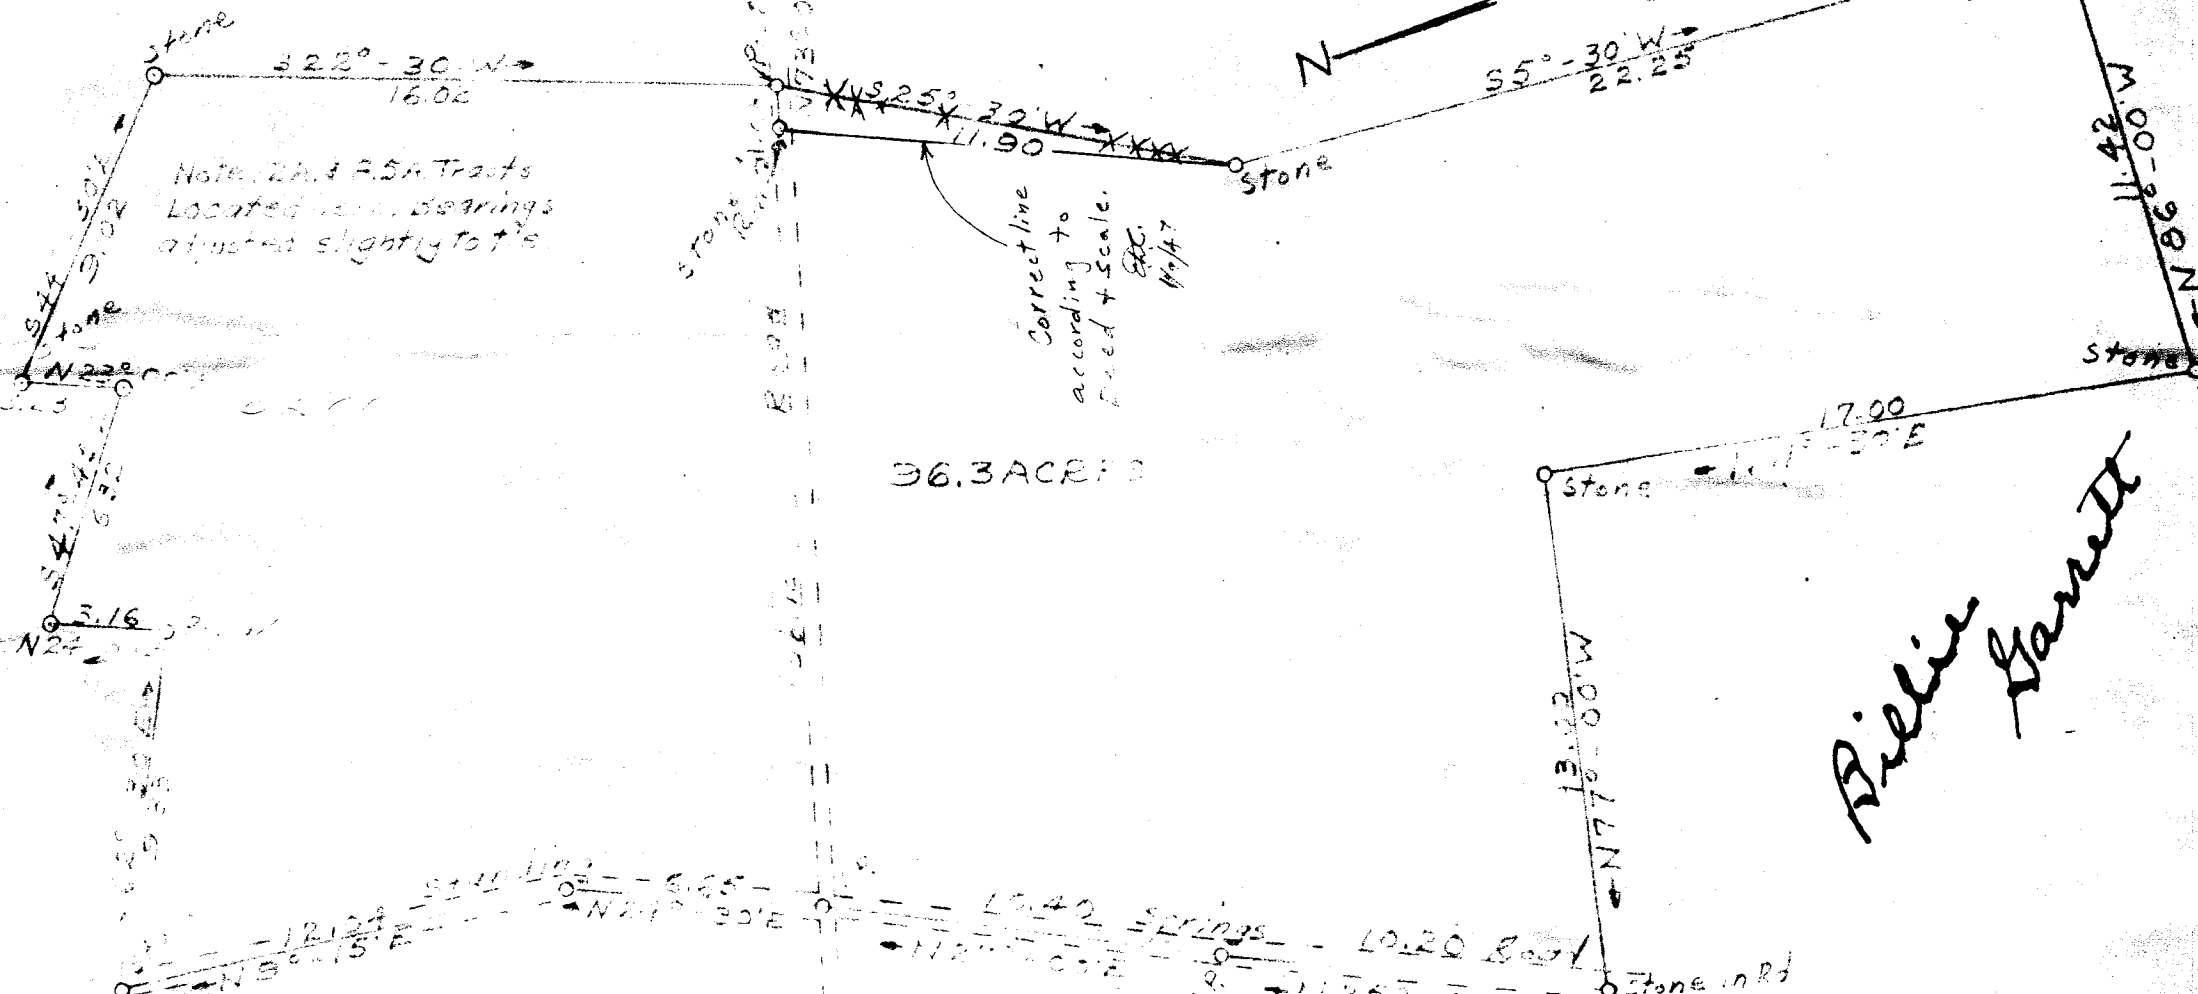

Billie Gantt

Balsam Land

PROPERTY OF JOHN E. BASKIN
 ADJOINING TOWNSHIP - GREENVILLE COUNTY S.C.
 Scale 1" = 5 Ch. Dec. 1946

J.M. ...

...
 (S...)
 as shown by Ex. 30 to 345 (1st 1/2 of B.A. Bk. 29) by 347 (vert into Bk.) 12/5/47.