


JUL 29 1950

18351

FILED
GREENVILLE CO. S. C.

JUL 29 9 24 AM 1950

OLLIE FARNSWORTH
R. M. C.

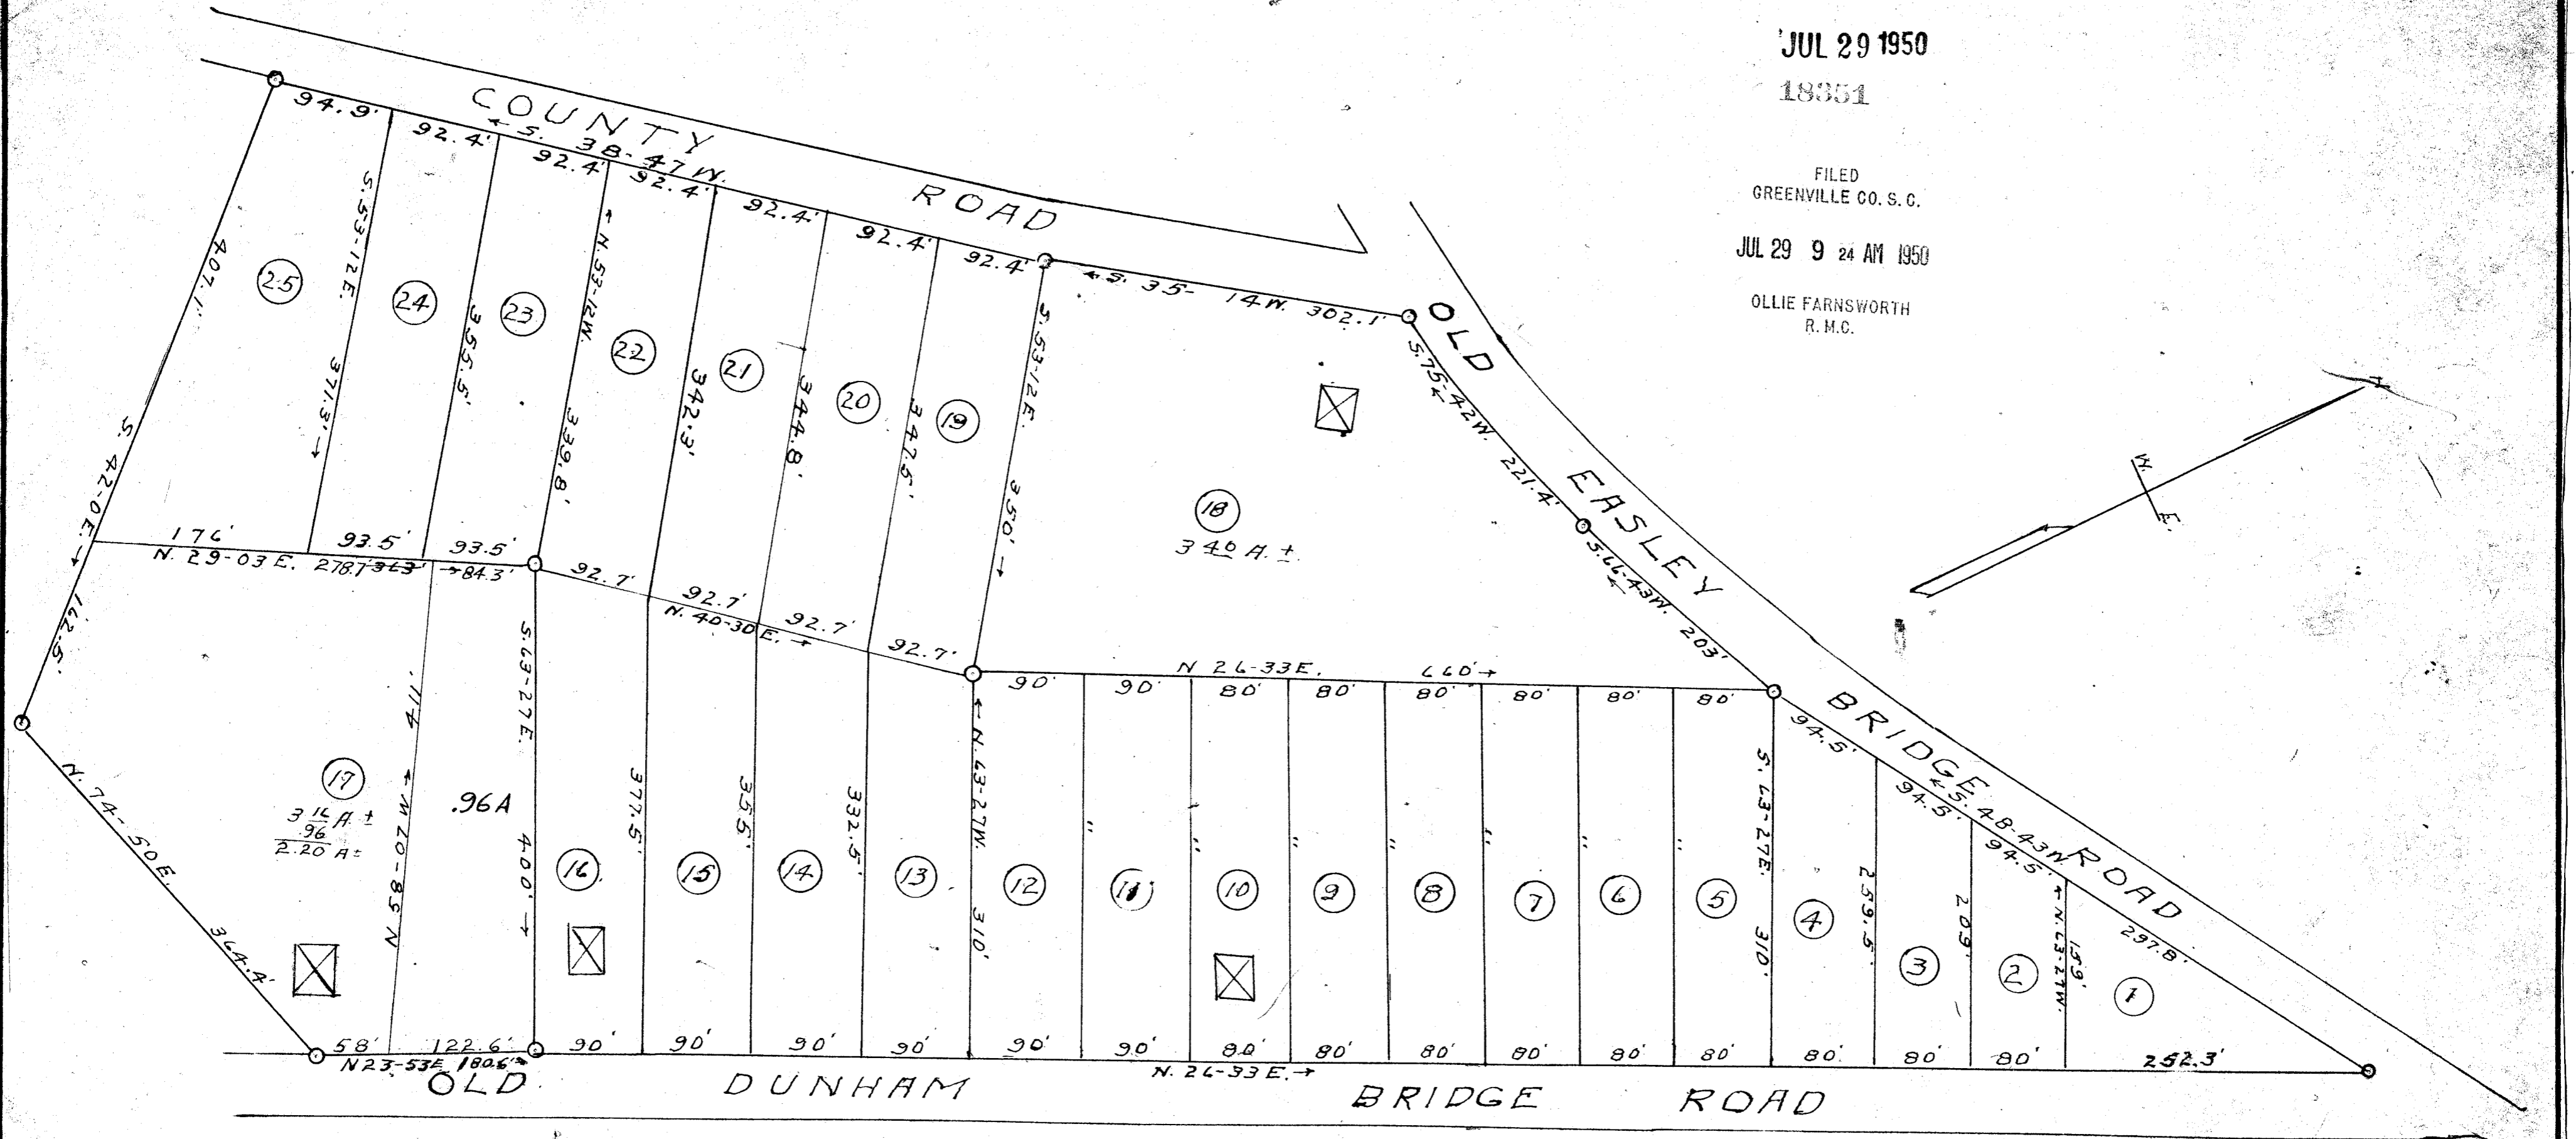

Note: lot No 17 divided
July 27, 1950 by W. J. R.

PROPERTY OF
ESTATE OF ARTHUR J. PHILLIPS DECD.
NEAR GREENVILLE, S. C.

Scale 1" = 100' ----- April 1948

W. J. Riddle - surveyor

#18351 paid This 29 day of July 1950
And Recorded in Vol. 97 at 9:24 AM
Ollie Farnsworth
Register & Clerk Greenville County, S. C.