


200

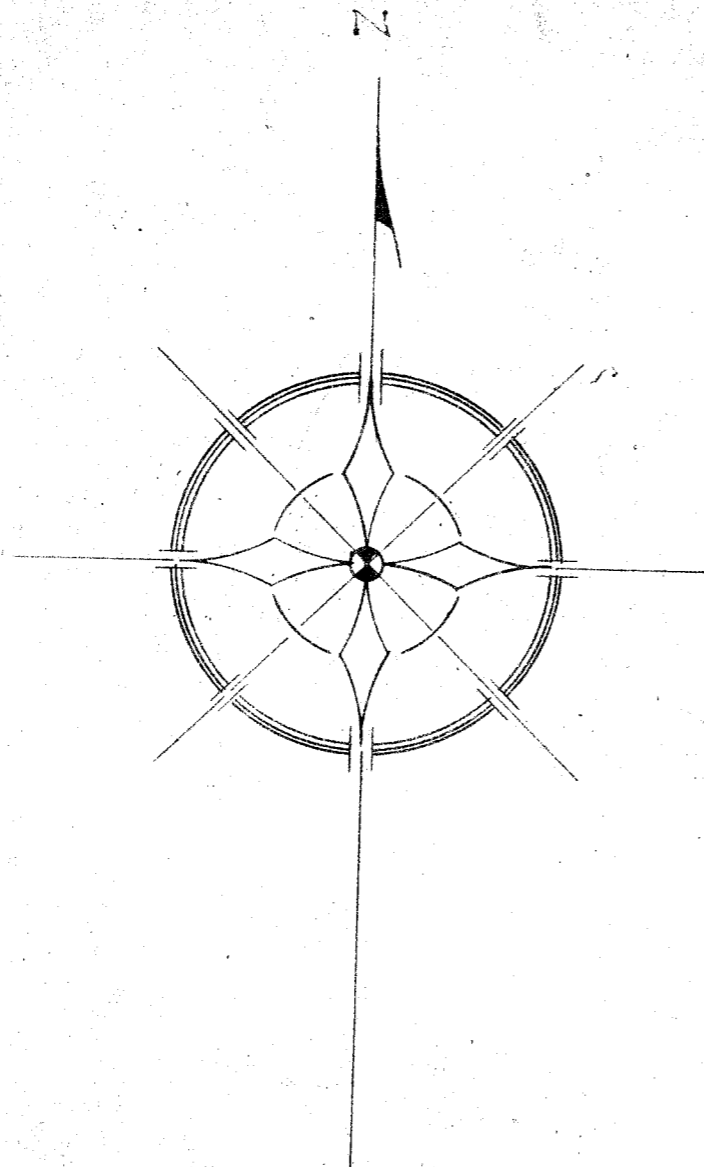

Note-Lots 204-205&Part of Lot 150 Revised Feb. 1949
Addition to Map made February 1949
Devision Lot 272 made April 1949-A thru M



Iron Pins at a