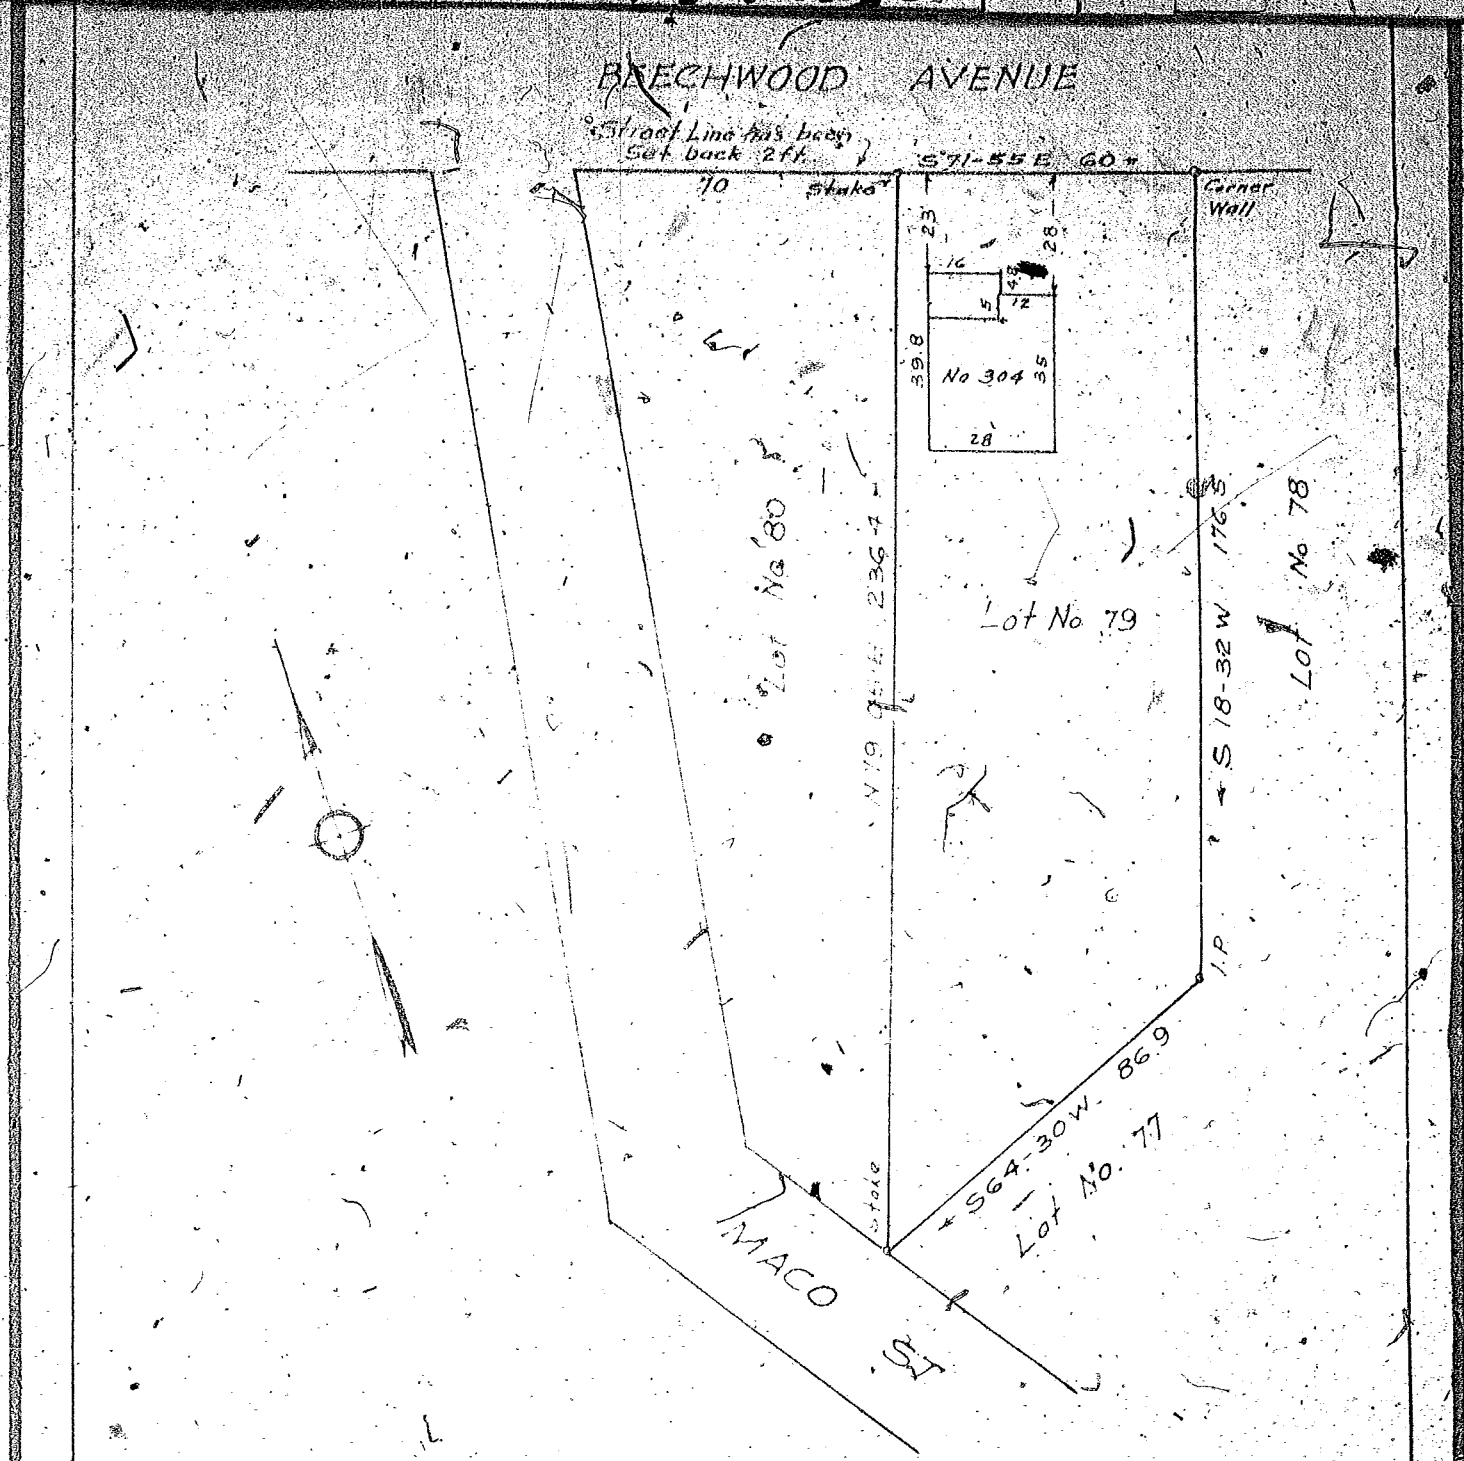

PROPERTY OF
THOMAS M WRIGHT AND
RUTH HANNAH WRIGHT
NEAR GREENVILLE S.C.
Scale 1"=40' Jan. 1944

This is to certify that on the 21st day of January 1944, I surveyed the property shown on this plat, and that the property lines, wells and buildings are as shown hereon; that the buildings located on said lot do not encroach or project on adjacent streets or property; and that no adjacent buildings or walls encroach or project on said premises.

R E Dalton
Registered Engineer.