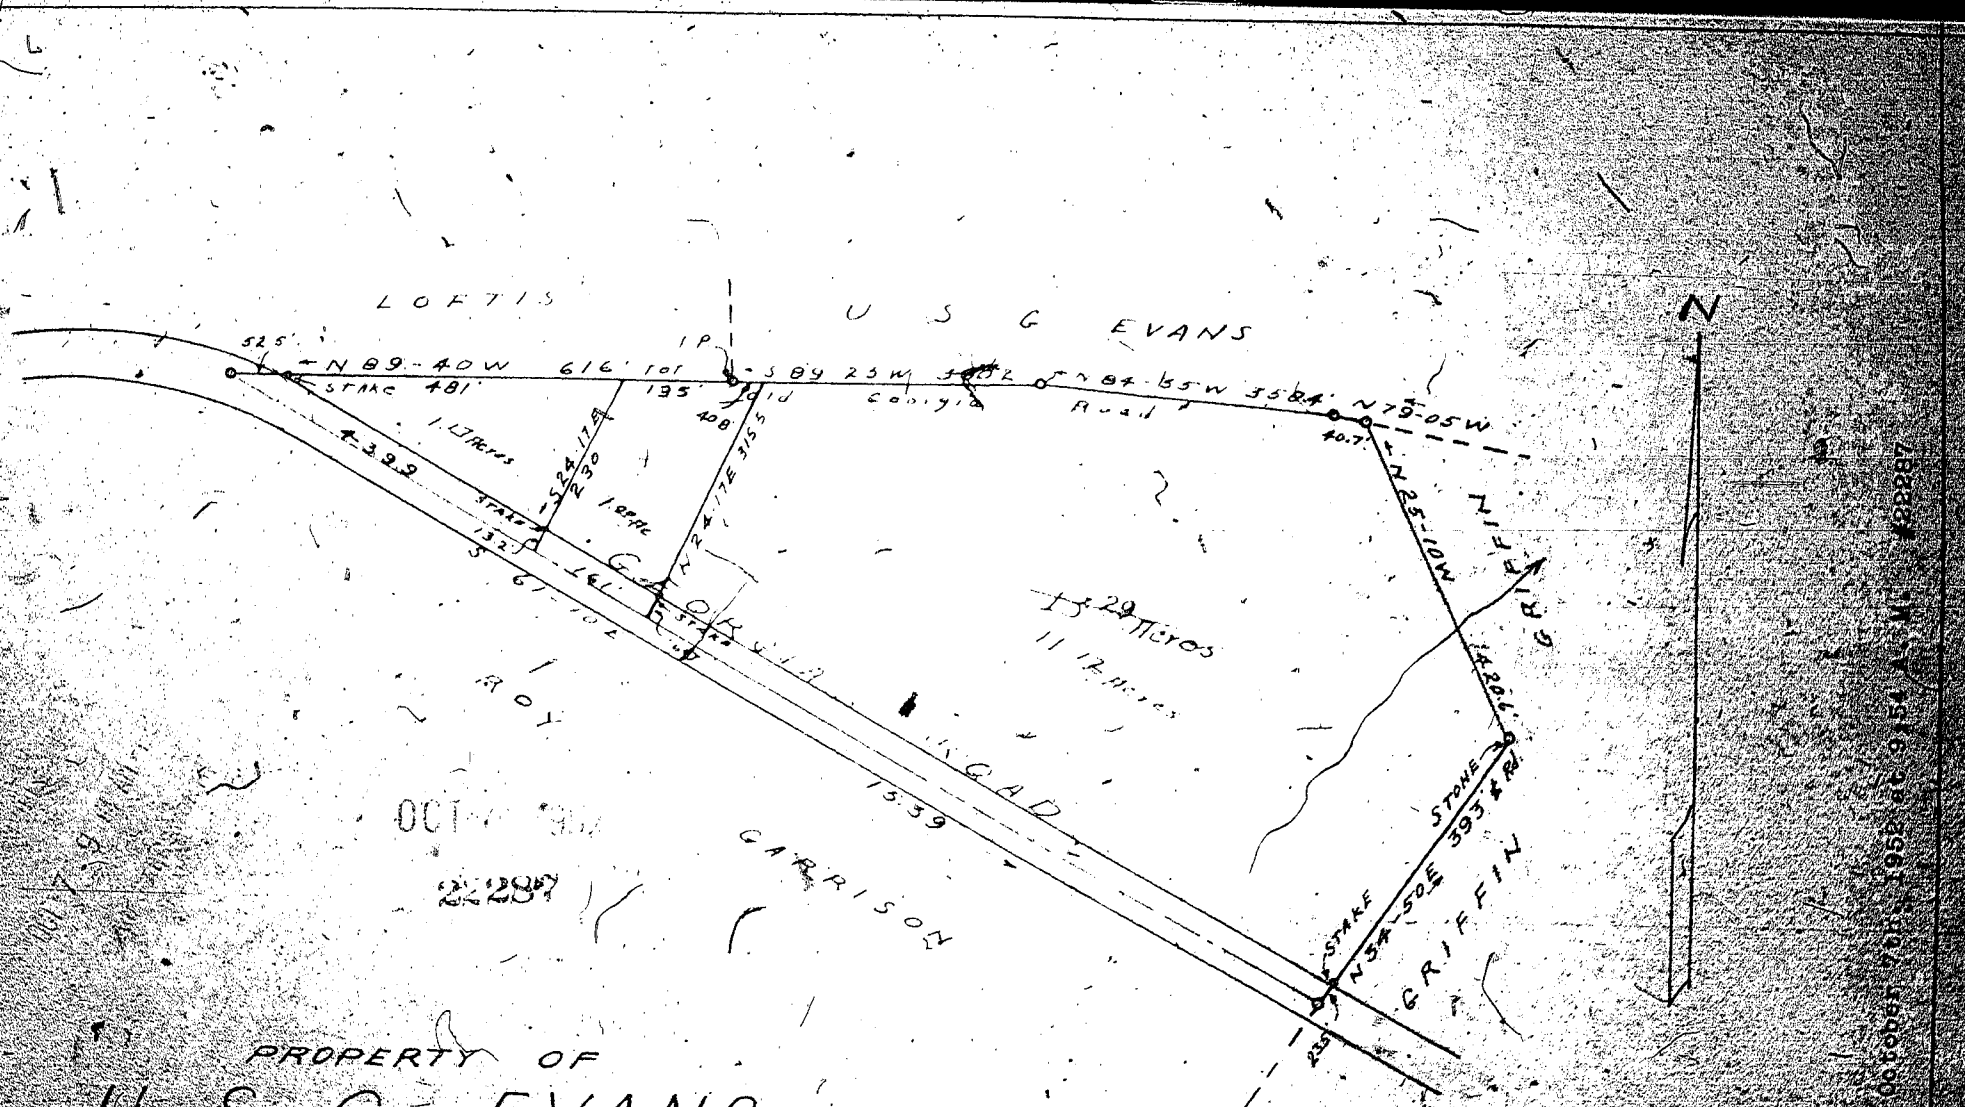
LOFTIS
U S G EVANS
525'
N 89-40W 616' to
STAKE 481
IP
S 89 23W
N 84-45W 558.4'
N 79-05W
40.7'
N 25-10W
1428'
GRIFFIN
N 54-50E 393' to Rd.
STONE
GRIFFIN
S 67-10E 1339'
N 24-17E 315'
S 24-17E 230'
1.0 Ac.
15.29 Acres
11.12 Acres
GARRISON
ROAD
22287
PROPERTY OF
U. S. G. EVANS
GREENVILLE COUNTY S. C.
SCALE 1"=200'
DEC. 27, 1951
Note: Plat revised 9/24/52 by C.A.R.
Book 22287
W. J. Riddle Surveyor